Marion


KANSAS

SECTION 36 TOWNSHIP 21S RANGE 4E

WELL NO. #1 Slocombe "B"

COMPANY E. H. Adair

NORTH SE NW NE

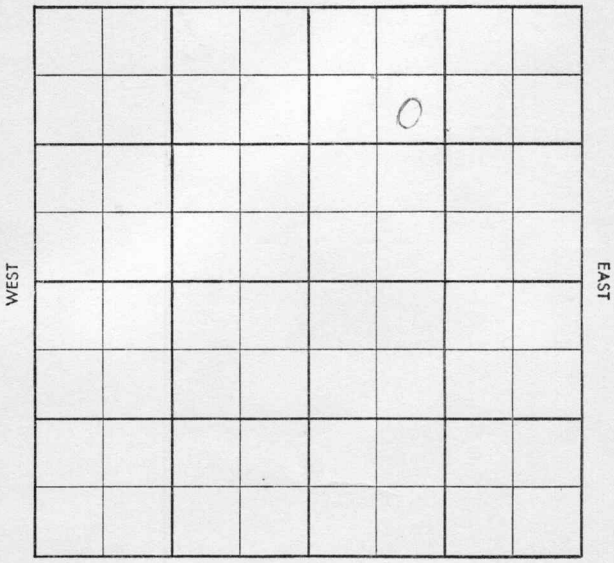

Twp. X Pool X

Co. X Feast X

S-513-B

County Marion Elev.

Sec. 36 Twp. 21 Rge. 4E

Company E. H. Adair

Farm Name Slocombe "B" No. 1

| TOPS | DEPTH | LOG | DATUM |
|---|---|---|---|
| Anh. | | | |
| Tp. | | | |
| H. | | | |
| Tr. | | | |
| Dg. | | | |
| B. L. | | | |
| L. | | | |
| K.C. | | | |
| B.K.C. | | | |
| Ce. | | | |
| C. | | | |
| M. | | | |
| M. | | | |
| K. | | | |
| Mz. | | | |
| Mq. | | | |
| V. | | | |
| S. | | | |
| S. | | | |
| A. | | | |
| R. | | | |
| Pf. | | | |
| G. | | | |
| T.D. | | | |

Loc. in Sec. SE NW NE

Geol.

Contr. Co. tools

Pool Fairplay




Lse. No. Sec. T. R.

Date Comm. 4-24-58

8" @ 170 drlg. 1425

Twp._____ Pool_____

Co._____ Facet_____

S-513-B

County Marion Elev. 1345 DF 1348 RB

Sec. 36 Twp. 21 Rge. 4E

Company E. H. Adair

Farm Name Slocombe "B" No. 1

| TOPS | DEPTH | LOG | DATUM |
|---|---|---|---|
| Anh. | | | |
| Tp. | | | |
| H. | | | |
| Tr. | | | |
| Dg. | | | |
| B. L. | | | |
| L. | | | |
| K.C. | | | |
| B.K.C. | 2052 | | |
| Ce. | | | |
| C. | | | |
| M. Chat | 2210 | | |
| M. | | | |
| K. 3h | 2264 | | |
| Mc. chatn | 2373 | | |
| Mq. Mz | 2395 | | |
| V. Hunt | 2399 | | |
| S. | | | |
| S. | | | |
| A. | | | |
| R. | | | |
| Pf. | | | |
| G. | | | |
| T.D. | 2404 | | |

Loc. in Sec. SE NW NE

Geol.

Contr. #1 Co. tools

Pool Fairplay

MAY 7 '58

ABANDONED

Date Comm. 4-24-58

8" @ 170 drlg. 1425 MAY 7 '58 no log

D&A

Co. Lse. Sec. T. R.