

Lyon


KANSAS ✓

FORM 51 25M 3-49 PETROL

Section 36 Township 21 Range 11E

Well No. #1 Hind

Company George Sauder

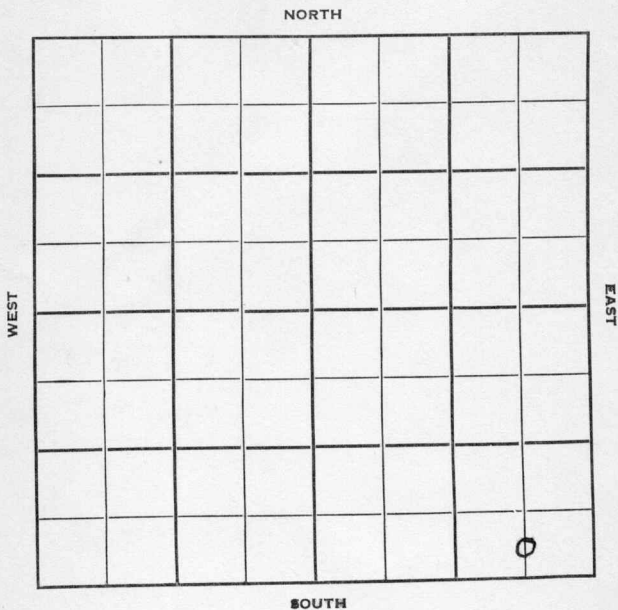

Lyon

Sec. 36 Twp. 21 R. 11E ✓

Well No. #1 Hind Farm

George Sauder Company

Jackman & Jackman - Contr. Contractor
Wildcat


 Ft. from N. Line

330' Ft. from S. Line

660' Ft. from E. Line

 Ft. from W. Line

C S L SE SE

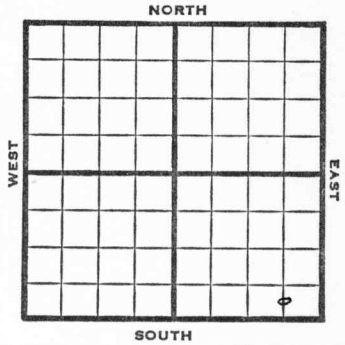

1950	Elev. REPORT
12/27	RUR
1951 1/10	D&A TD 1986 Bart 1820 Miss 1960 TD 1986 D&A ABANDONED

County **Lyon** State **Kansas**

Sec. **36** (Blk. **21** (Sur. **11E** Map No. **11E**)
(Twp.)

Operator **George Sauder**

Well No. **1** Farm **Hind**

Elev. _____ Location **C S L SE SE**

330 Ft. From **S** Line **SE**

660 Ft. From **E** Line **Quarter**

1st. Report **DEC 27 1950**

Completion _____

Remarks _____

Jackman & Jackman - Contr

Spudding Date _____

Drlg. Data **Wildcat**

R U R

County Lyon State Kansas

Sec. 36 (Blk.) 21 (Sur.) 11E Map No.
 (Twp.) (Rge.)

Operator George Sauder

Well No. 1 Farm Hind

Elev. _____ Location C S L S E S E



330 Ft. From S Line SE

660 Ft. From E Line Quarter

Ist. Report _____

Completion JAN 1 0 1951

Remarks Wildcat

Jackman & Jackman - Contr.

Spudding Date _____

Drlg. Data D & A TD 1986

Bart. 1820 Miss. 1960 TD 1986

D & A