


Map No. **KANSAS** Sec. **36** Twp. **21** R. **11E**
 Well No. **1-Lincoln** Farm
Basometal Company

NORTH

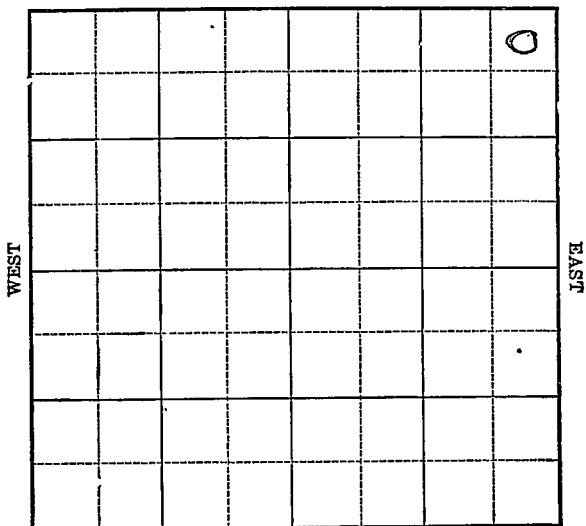

SOUTH

Location _____

Drilling Remarks _____

Rig Up _____

Drilling Remarks _____

RECORD

Cased _____ in. _____ ft.

Sand _____

Gas _____

Oil _____

Total Depth _____

PRODUCTION

1st 24 hrs. Nat. _____

1st 24 hrs. after shot _____

Gas _____ cu. ft.

Dry Hole _____

Abandoned _____

KANSAS

Map No. _____ Sec. 36 Twp. 21 R. 11Well No. 1 Lincoln FarmBasom et al Company

NORTH

330 Ft. from N. Line

_____ Ft. from S. Line

330 Ft. from E. Line

_____ Ft. from W. Line

WEST

EAST

SOUTH

1927

Date

REPORT

11/30 Location12/7 —12/14 —12/21 —12/29 —1928 —1/5 —1/11 —1/18 —1/26 —2/2 —2/9 —2/16 —2/23 Machine3/1 —3/8 Drly 10253/16 " 12223/21 Top line 1933 - H.E.W.N.A. 1933'

21 KANSAS Sec. 36 Twp. 21 R. 11 E
 Well No. 1 Lincoln
 Basom et al Company

Contractor

FIRST REPORTS

330 Ft. from N. Line

Ft. from S. Line

330 Ft. from E. Line

Ft. from W. Line

SECTION PLAT

			0

Location ✓

Rig up

Drilling and Remarks:

RECORD

Cased _____ in., _____ ft.

Sand _____

Gas _____

Oil _____

Total Depth _____

PRODUCTION

1st 24 hrs. Nat. _____

1st 24 hrs. after shot _____

Gas _____ Cu. Ft.

Dry Hole _____

Abandoned _____

Date

NOV 30 1927

CHAS. L. SHERWOOD

192

Scout

21 KANSAS 36 21 11
 Map No. Sec. Twp. R.
 Well No. 1 Lincoln
 Basson Oil Company

Contractor

COMPLETED

SECTION PLAT

330 Ft. from N. Line

Ft. from S. Line

330 Ft. from E. Line

Ft. from W. Line

			0

ABANDONED

Location

Rig up

Drilling and Remarks:

top run 1933

AFW

DQW 1933

RECORD

Cased in., ft.

Sand

Gas

Oil

Total Depth 1933

PRODUCTION

1st 24 hrs. Nat.

1st 24 hrs. after shot

Gas Cu. Ft.

Dry Hole ✓

Abandoned ✓

Date

MAR 21 1928

CHAS. L. SHERWOOD

Scout