

33-21-46
(REV) ACO-1
IND

This form shall be filed in duplicate with the Kansas Corporation Commission, 200 Colorado Derby Building, Wichita, Kansas 67202, within ten days after the completion of the well, regardless of how the well was completed.

Attach separate letter of request if the information is to be held confidential. If confidential, only file one copy. Information on side one will be of public record and side two will then be held confidential.

Circle one: Oil, Gas, Dry, SWD, OWWO, Injection. Type and complete ALL sections. Applications must be filed for dual completion, commingling, SWD and injection.

Attach wireline logs (i.e. electrical log, sonic log, gamma ray neutron log, etc.). KCC # (316) 263-3238. (Rules 82-2-105 & 82-2-125)

State Geological Survey
WICHITA BRANCH

OPERATOR Range Oil Company, Inc.

API NO. 15-115-20,828

ADDRESS 240 Page Court, 220 W. Douglas

COUNTY Marion

Wichita, Ks 67202

DRILLERS LOG

FIELD _____

**CONTACT PERSON John M. Washburn

PROD. FORMATION _____

PHONE 265-6231

LEASE DeForest

PURCHASER _____

WELL NO. #1

ADDRESS _____

WELL LOCATION 1340 FNL & 1360 FWL OF NW/4

DRILLING Range Drilling Co., Inc.

1340 Ft. from North Line and

CONTRACTOR _____

1360 Ft. from West Line of

ADDRESS 240 Page Court, 220 W. Douglas

the NW/4 SEC. 33 TWP. 21 RGE. 4E

Wichita, Ks 67202

WELL PLAT

PLUGGING _____

RECEIVED

CONTRACTOR _____


STATE CORPORATION COMMISSION

ADDRESS _____

MAR 1 1982

CONSERVATION DIVISION

TOTAL DEPTH 2353 PBTD Wichita Kansas

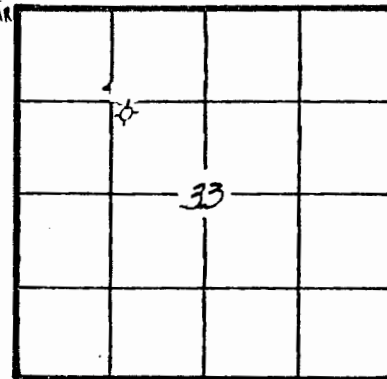

KCC
KGS _____
(Office Use)

SPUD DATE 11-23-81 DATE COMPLETED 12-4-81

ELEV: GR 1392 DF _____ KB 1397

DRILLED WITH (CABLE) (ROTARY) (AIR) TOOLS

Amount of surface pipe set and cemented 8 5/8 @ 168' DV Tool Used? NO

AFFIDAVIT

STATE OF Kansas, COUNTY OF Sedgwick SS, I, _____

John M. Washburn OF LAWFUL AGE, BEING FIRST DULY SWORN UPON HIS OATH,

DEPOSES THAT HE IS Chief Geologist (FOR) ~~(OF)~~ Range Oil Company, Inc.

OPERATOR OF THE DeForest LEASE, AND IS DULY AUTHORIZED TO MAKE

THIS AFFIDAVIT FOR AND ON THE BEHALF OF SAID OPERATOR, THAT WELL NO. #1 ON

SAID LEASE HAS BEEN COMPLETED AS OF THE 4th DAY OF December, 1981, AND THAT

INFORMATION ENTERED HEREIN WITH RESPECT TO SAID WELL IS TRUE AND CORRECT.

