


DX 78-1 Marion

KANSAS

Section 4 Township 21 Range 3E

Well No. #1 Siebert

Company Beaumont Pet.

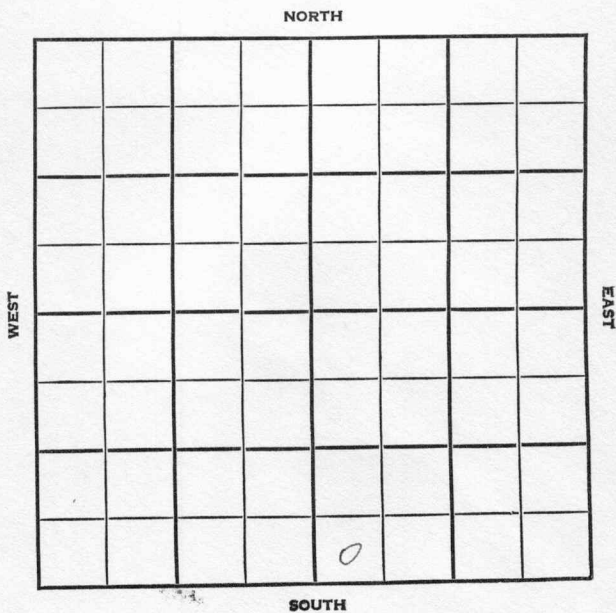

Marion

KANSAS

SEC.

TWP.

R.

4

21

3E

WELL NO.

#1 Siebert

FARM

COMPANY

Beaumont Petr.

CONTRACTOR

Co. Tools

WILDCAT


FT. FROM N. LINE

FT. FROM S. LINE

FT. FROM E. LINE

FT. FROM W. LINE

SW SW SE

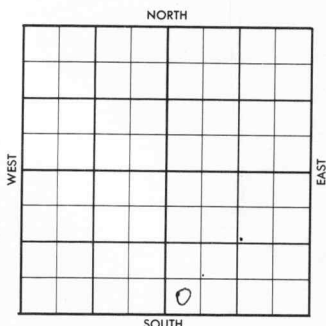

ELEVATION

1956

1392'

REPORT

8-8 Setting Surface

8-22 Comm. 8-9-56

10" @ 131

D & A

L. 1920'; BKC 2294'; Marm 2344';

Ce. 2484'; Cg. sd. 2490'; M. Chert 2503';

Mi. Li. 2582'; Kd. sh. 2624';

Crystline Li. 2789'; Mq. sh. 2799';

Viola 2833';

TD 2871'

ABANDONED

County Marion Elev. _____
 Sec. 4 Twp. 21 Rge. 3E
 Company Beaumont Pet.
 Farm Name Siebert No. 1

TOPS	DEPTH	LOG	DATUM	Loc. in Sec.
Anh.				SW SW SE
Tp.				
H.				
Tr.				
Dg.				
Bl.				
L.				Geol.
K.C.				Contr.
B.K.C.				Co. tools
Ce.				
C.				Pool
M.				Wildcat
M.				
K.				
Mz.				
Me.				
V.				
S.				
S.				
A.				
R.				
Pe.				
G.				
T.D.				

FIRST REPORT

Date Comm.

AUG 8 '56

setting surface

AUG 1 9 1956

R.G.

County Marion Elev. 1392
 Sec. 4 Twp. 21 Rge. 3E
 Company Beaumont Pet.
 Farm Name Siebert No. 1

TOPS	DEPTH	LOG	DATUM	Loc. in Sec.
Anh.				SW SW SE
TP.				
H.				
Tr.				
Dg.				
BL.				
L.	1920			Geol.
K.C.				Contr.
B.K.C.	2294			Co. tools
Ce. <u>Marm</u>	2344			
Ce. <u>ce</u>	2484			Pool
M. <u>cg sd</u>	2490			Wildcat
M. <u>chert</u>	2503			
K. <u>M. L.</u>	2582			
M. <u>Kd sh</u>	2624			
Ma.				
V. <u>Crystline</u>	2189			
S. <u>Mash</u>	2799			
S. <u>Viola</u>	2833			
A.				
R.				
PE.				
G.				
TD.	2871			

AUG 22 1956

Date Comm.

setting surface

AUG 15 '56

8-8-56

10" 131 17 1955

AUG 22 '56

D&A