Form 27—100 Bks.—4-48—Petrol

Marion County Kansas State

Map No. Sec. 10 Twp. 21 R. 5E


Well No. 1 Lodouette

Sible etal. Company

FIRST REPORT Contractor

NE SE

SECTION PLAT

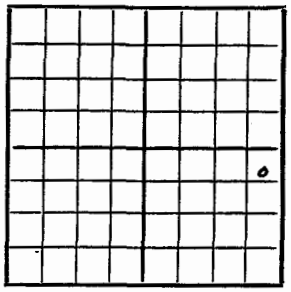

330 Ft. from N. Line

Ft. from S. Line

330 Ft. from E. Line

Ft. from W. Line

Wildcat

Remarks:

Machine

Date AUG 4 1948 Scout S. J. LEWIS

Form 27—100 Bks.—4-48—Petrol

Marion County Kansas State

Map No. 23 Sec. 10 Twp. 21 R. 5E

Well No. 1 Lodouette


Sible etal. Company

ABANDONED Contractor

NE SE

E 1/1257

SECTION PLAT

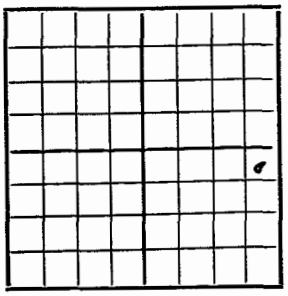

330 Ft. from N. Line

Ft. from S. Line

330 Ft. from E. Line

Ft. from W. Line

Wildcat

Remarks:

Miss 2105
Viola 2264
TD 2266

Date SEP 1 1948 Scout S. J. LEWIS

FORM 252-A
5M 4-48 PETROL


KANSAS Marion

Sec. 10 Twp. 21 R. 5-E ✓

Well No. #1 Lodouette Farm

Sible etal Company

Wildcat

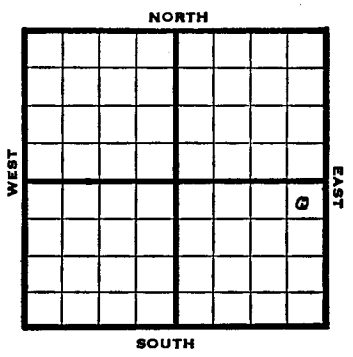


330 Ft. from N. Line

_____ Ft. from S. Line

330 Ft. from E. Line

_____ Ft. from W. Line

NE SE

| 1948 | Eli 1259' REPORT |
|---|---|
| 8/4 | Machine |
| 8/11 | 15"@ 181' |
| | Drlg 2017' |
| 8/18 | 12"@ 864' |
| | Drlg 960' |
| 8/25 | 10"@ 1410' |
| | Drlg 1720' |
| 9/1 | Miss 2105' |
| | Viola 2264' |
| | TD 2266' |
| | Aband. |
| | ABANDONED |

FORM 51 10M 7-48 PETROL

KANSAS Marion

Section 10 Township 21 Range 5E

Well No. 1 Lodouette LALOUETTE

Company Sible et al SEIBEL

