WILDCAT

FORM 513 SUNRAY

County Marion Elev.
Sec. 10 Twp. 21 Rge. 5E
Company White & Ellis Drlg.
Farm Name LaLovette "B" No. 1

TOPS	DEPTH	LOG	DATUM
Anh.			
Tp.			
H.			
Tr.			
Dg.			
Bl.			
L.			
K.C.			
B.K.C.			
Ce.			
C.			
M.			
M.			
K.			
Mz.			
Mo.			
V.			
S.			
S.			
A			
R.			
P€.			
G.			
TD			

Loc. in Sec. SW NW SW
Geol.
Contr. Co. Tools
Pool Wildcat

FIRST REPORT
FEB 20 '57

Date Comm. 2-15-57
8" @ 112/100 W O R T

Co. Lse. No. Sec. T. R.

FORM 513 SUNRAY **CORRECTION**

County Marion Elev. 1265 DF
Sec. 10 Twp. 21 Rge. 5E
Company White & Ellis Drlg.
Farm Name ~~Ernst~~ LaLovette No. 1

TOPS	DEPTH	LOG	DATUM
Anh.			
Tp.			
H.			
Tr.			
Dg.			
Bl.			
L.			
K.C.	1495 1908		
B.K.C.			
Ce.			
C.			
M.			
M.			
K. Hunt	2102 2232		
Mz.			
Mo.			
V.			
S.			
S.			
A			
R.			
P€.			
G.			
TD	2237		

Loc. in Sec. SW NW SW
Geol.
Contr. Co. Tools
Pool Wildcat

COMPLETE
APR 17 '57

Date Comm. 2-15-57
8" @ 112/100 W O R T FEB 27 '57 WOR
8" @ 2232 X DST 2231-37
open 30" 1138' oil + 40' OCM FP
5-585 BHP 870 5½ @ 2233
MAR 13 '57 DST 2231-37 (30) 1138 Oil
180 OCM FP 585- BHP 870 (20)
39° RTD 2237 5½ 2233/40
CO 2237 TD MAR 27 '57 T & R MAR 27 '57
P. 60 Bopd + Tr. wtr. APR 3 '57 APR 10 '57
APR 17 '57 P. 25 Bopd + Tr. wtr grav 39°


Co. Lse. No. Sec. T. R.

Marion **KANSAS**

SECTION 10 TOWNSHIP 21 RANGE 5E

WELL NO. #1 LaLovette "B"

COMPANY White & Ellis Drlg.

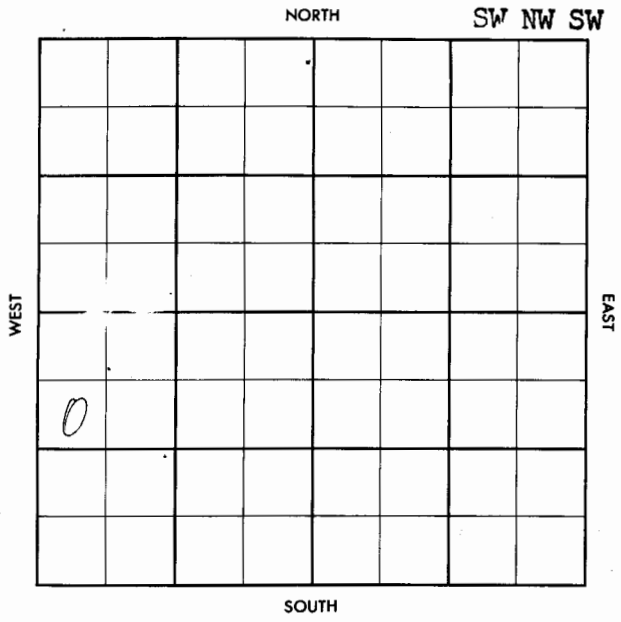

FORM 504-3 SUNRAY