


Map No. **KANSAS** Sec. **5** Twp. **21** R. **10**
 Well No. **1 - Lessman** Farm
Prairie O. & Y. Tenman Bros Company

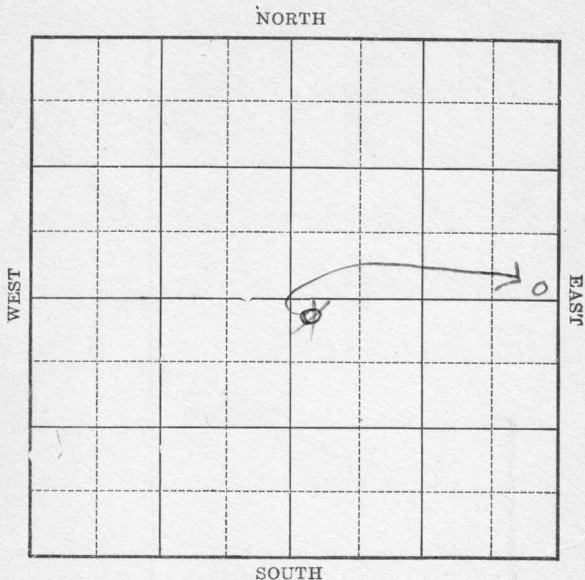

Location _____

Drilling Remarks

Rig Up _____

Drilling Remarks

RECORD

Cased _____ in. _____ ft.

Sand _____

Gas _____

Oil _____

Total Depth _____

PRODUCTION

1st 24 hrs. Nat. _____

1st 24 hrs. after shot _____


Gas _____ cu. ft.

Dry Hole _____

Abandoned _____

Map No. Kansas Sec. 5 Twp. 21 R. 10Well No. 1 Lessman FarmPrairie O.G. & Senman Bros Company

NORTH

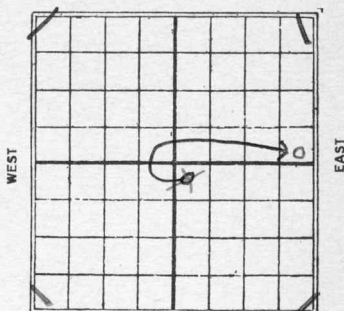

SOUTH

~~250~~ Ft. from N. Line250 Ft. from S. Line250 Ft. from E. Line~~250~~ Ft. from W. Line

Date

REPORT

1/26
1/14 Location
1/20 Drilling
1/21 Rig
2/4 Rigging up
2/10 Spudding
2/17 Drlg 600'
2/24 Drlg 1240' Sd. 1920-35
2/24 Sd 1980-1995'
3/5
3/10 Drlg 1625 H.F.W.
3/18 " 1740
3/25 Sandy shale 21-44-59.
3/25 Shale 2159-2225' S.D.
4/1
4/7
4/15 Drlg 2232
4/21 Top line 2350' Drlg 2450
4/28 W.R. 2485
5/8 Drlg 2575
5/14 S.D. 2700 for 5"
5/19 S.D. 2789 Hfw.
5/26 S.D. 2780 Hfw. Sandy.
5/26 shale. 2144-59 S.D. 2350.

K-21 KANSAS Sec 5 Twp. 21 R. 10

Well No. 1
 Frankie & Dennis Bros Company

Contractor

COMPLETED

SECTION PLAT

_____ Ft. from N. Line

250 _____ Ft. from S. Line

250 _____ Ft. from E. Line

_____ Ft. from W. Line

ABANDONED

			0

Location _____

Rig up _____

Drilling and Remarks:

50 y shal 2144-59
 Top lin 2350'

100 y
 2780'

RECORD

Cased _____ in., _____ ft.

Sand _____

Gas _____

Oil _____

Total Depth 2780 AFN.

PRODUCTION

1st 24 hrs. Nat. _____

1st 24 hrs. after shot _____

Gas _____ Cu. Ft.

Dry Hole ✓ _____

Abandoned ✓ _____

Date

MAY 26 1926

192

CHAS. L. SHERWOOD

Scout

21 Map No. KANSAS Sec. 5 Twp. 21 R. 10

Well No. 1 Lessemans
Pratt 0252 Lessemans Bros. Company

Contractor

FIRST REPORTS


SECTION PLAT

250 Ft. from N. Line

_____ Ft. from S. Line

_____ Ft. from E. Line

250 Ft. from W. Line

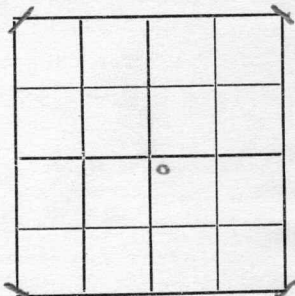

Location ☒ _____

Rig up _____

Drilling and Remarks:

RECORD

Cased _____ in., _____ ft.

Sand _____

Gas _____

Oil _____

Total Depth _____

PRODUCTION

1st 24 hrs. Nat. _____

1st 24 hrs. after shot _____

Gas _____ Cu. Ft.

Dry Hole _____

Abandoned _____

Date

JAN 14 1926

CHAS. L. SHERWOOD

192

Scout


1621 KANSAS 5 31 10
 Map No. Sec. Twp. R.

Well No. 1 Lessman
 Prairie of 32 Donnan Bros Company

Contractor

CORRECTION

SECTION PLAT

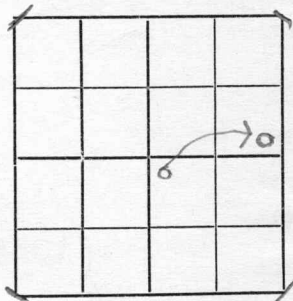

Ft. from N. Line

250 Ft. from S. Line

250 Ft. from E. Line

Ft. from W. Line

Location

Rig up

Drilling and Remarks:

Chq Location
 to shoe.

RECORD

Cased _____ in., _____ ft.

Sand _____

Gas _____

Oil _____

Total Depth _____

PRODUCTION

1st 24 hrs. Nat. _____

1st 24 hrs. after shot _____

Gas _____ Cu. Ft.

Dry Hole _____

Abandoned _____

Date

JAN 20 1926

192 CHAS. L. SHERWOOD

Scout