


Chase Co
K23 KANSAS
Map No. 19 Sec. 21 Twp. 6 R. 6
Well No. 1 Phipps
Higgett et al Company
Contractor

FIRST REPORTS

SECTION PLAT

200 Ft. from N. Line
Ft. from S. Line
200 Ft. from E. Line
Ft. from W. Line

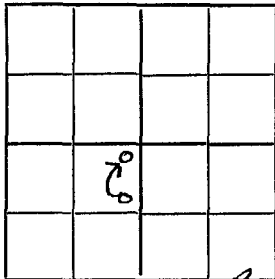

old well going deeper. 1st report

Location

Rig up

Drilling and Remarks:

Repairing Rig.
2.0. 1760

Formerly carried
to security oil
and its Co.
Date

RECORD
Cased in. ft.

Sand

Gas

Oil

Total Depth

PRODUCTION

1st 24 hrs. Nat.

1st 24 hrs. after shot

Gas Cu. Ft.

Dry Hole

Abandoned


OCT 29 1925 CHAS. L. SHERWOOD
Scout

Chase
K23 KANSAS
Map No. 19 Sec. 21 Twp. 6 R. 6
Well No. 1 Phipps
Higgett et al Company
Contractor

COMPLETED

SECTION PLAT

200 Ft. from N. Line
Ft. from S. Line
200 Ft. from E. Line
Ft. from W. Line

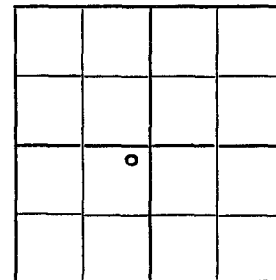

ABANDONED

Location

Rig up

Drilling and Remarks:

1 day.

RECORD

Cased in. ft.

Sand

Gas

Oil

Total Depth 2605

PRODUCTION

1st 24 hrs. Nat.

1st 24 hrs. after shot

Gas Cu. Ft.

Dry Hole

Abandoned

Date
APR 14 1926

CHAS. L. SHERWOOD
Scout

Chase Co
 Map No. Kansas Sec. 19 Twp. 21 R. 6
 Well No. 1 Griffith Farm
Leggett et al Company

4/1 - S.D. 2603

4/7 -


4/14 - S. & A. 2605

200 Ft. from N. Line

Ft. from S. Line

200 Ft. from E. Line

Ft. from W. Line

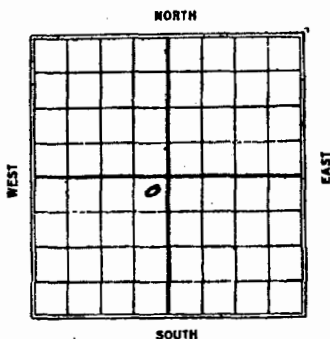

Date	REPORT
1925	
10/29	Repairing Ry T.D. 1760
11/6	
11/13	
11/19	
11-27	Dwg 1820
12/3	✓ 1865
12/10	cleaning out 1865
12/17	
12/23	S.D. 1980
12/31	S.D. 2005
1926	
1/4	
1/11	
1/20	Dwg 2100
1/27	✓ 2200
2/4	✓ 2
2/10	S.D. 2603
2/17	
2/24	
3/3	
3/10	
3/18	
3/25	

Abandoned _____