

Map No. _____ Sec. 15 Twp. 21 R. 6E

Well No. 1 Hindren

C. Sibel Company

H & M Drlg. Contractor

C S L SW SW


FIRST REPORT
SECTION PLAT

Ft. from N. Line

330 Ft. from S. Line

Ft. from E. Line

660 Ft. from W. Line

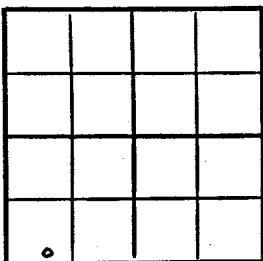

Chase County

Location

Rig up

Drilling and Remarks:

Machine

RECORD

Cased in, ft.

Sand

Gas

Oil

Total Depth

PRODUCTION

1st 24 hrs. Nat.

1st 24 hrs. after shot

Gas Cu. Ft.

Dry Hole

Abandoned

Date

AUG 24 1949 19 S. J. LEWIS Scout

Map No. _____ Sec. 15 Twp. 21 R. 6E

Well No. 1 Hindren

C. Sibel Company

ABANDONED

C S L SW SW


E11341
SECTION PLAT

Ft. from N. Line

330 Ft. from S. Line

Ft. from E. Line

660 Ft. from W. Line

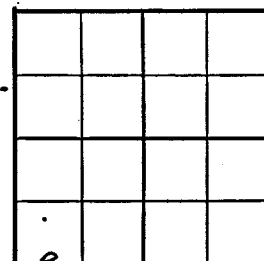

Chase County

Location

Rig up

Drilling and Remarks:

Miss 8145

RECORD

Cased in, ft.

Sand

Gas

Oil

Total Depth *302*

PRODUCTION

1st 24 hrs. Nat.

1st 24 hrs. after shot

Gas Cu. Ft.

Dry Hole

Abandoned

Date

NOV 23 1949 19 S. J. LEWIS Scout

KANSAS

Chase

Sec. 15 Twp. 21 R. 6EWell No. 1 Hindren Farm

C. Sibel

Wildcat Contr. H & M Drlg. Company


Ft. from N. Line

330 Ft. from S. Line

Ft. from E. Line

660 Ft. from W. Line

C S L SW SW

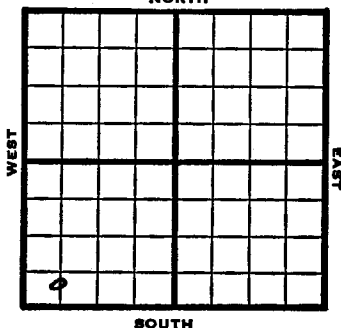

1949 Elev 1341' REPORT

8/24 Machine

8/31 15" @ 65'
Drlg. 275'

9/7 12" @ 1065'

9/14 10" @ 1496'
Lansing 1615'
8" @ 1635'
Drlg 1760'

9/21 "

9/28 KC 1913'
Drlg 2652'

10/5 "

10/12 "

10/19 Drlg 3065'

10/26 5" @ 3130'
Drlg. 3200'

11/1 Drlg. 3225'

11/9 Drlg 3485'

11/23 TD 3528'

Miss 3145'

Aband.

ABANDONED

KANSAS

Chase

Section 15 Township 21 Range 6-EWell No. #1 HindrenCompany C Sibel
Wildcat