

Map No. Sec. Twp. R.

Well No. Farm


..... Company

..... Ft. from N. Line

..... Ft. from S. Line

..... Ft. from E. Line

..... Ft. from W. Line

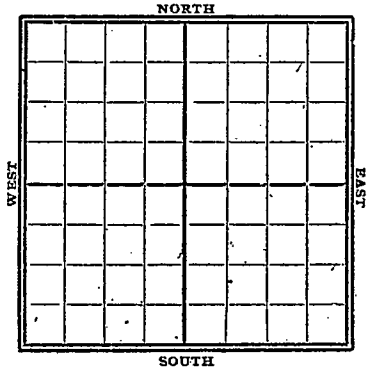

1920

Date

REPORT

Gypsy Records

11/15

Well TD 2806'

MAP No. _____ SEC. 6 TWP. 21S R. 4E

WELL No. 1 Scout
Hard + Boltcut COMPANY

CONTRACTOR _____

SECTION PLAT

		o	

_____ FT. FROM N. LINE
 _____ FT. FROM S. LINE
 _____ FT. FROM E. LINE
 _____ FT. FROM W. LINE

RECORD

LOCATION _____

CASED _____ IN., _____ FT.

RIG UP _____

SAND _____

DRILLING AND REMARKS:

GAS _____

OK with our camp

OIL _____

TOTAL DEPTH 2006

PRODUCTION

1ST 24 HRS. NAT. _____

1ST 24 HRS. AFTER SHOT _____

GAS _____ CU. FT.

DRY HOLE

ABANDONED

DATE Nov 15 1920

SCOUT