

Map No. **KANSAS** Sec. **5** Twp. **21** R. **7**
 Well No. **1 Eastern Kansas L & L**
Merriman Teindless Company

Contractor

FIRST REPORT

SECTION PLAT

200 Ft. from N. Line

0			

Ft. from S. Line

Ft. from E. Line

1120 Ft. from W. Line**ABANDONED**

Location

Rig up

Drilling and Remarks:

2049
2327

RECORD

Cased _____ in., _____ ft.

Sand _____

Gas _____

Oil _____

Total Depth _____

PRODUCTION

1st 24 hrs. Nat. _____

1st 24 hrs. after shot _____

Gas _____ Cu. Ft.

Dry Hole _____

Abandoned _____

Date

JUL 16 1923

192

M. A. BENEAR

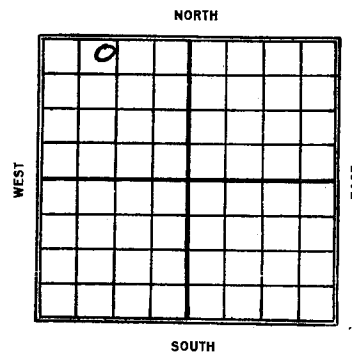
Scout

Map No. Sec. **5** Twp. **21** R. **7**
 Well No. **1 Eastern Kans. L & L** Farm
Merriman Teindless Company

200 Ft. from N. Line

Ft. from S. Line

Ft. from E. Line

1120 Ft. from W. Line

Date

1923**7/16**

REPORT

D. & A. 2527'

Map No. _____ Sec. 5 Twp. 21 R. 1
Well No. 1 Eastern Kans. L. & L. Farm
Merriman & Feindless Company


Rig up

Drilling Remarks:

RECORD

Cased_____in._____ft.

Sand

Gas

Oil.

Total Depth.

PRODUCTION

1st 24 hrs Nat.

1st 24 hrs. after shot.

Gas _____ **cu. ft.**

Dry Hole

Abandoned