


Marion

KANSAS

SECTION 7 TOWNSHIP 21 RANGE 3E

WELL NO. #2 Warkentin

COMPANY Milton Unger

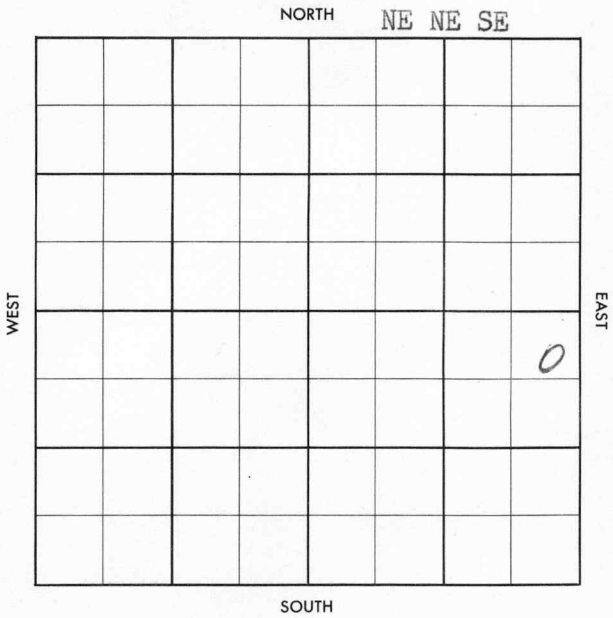

County Marion Elev. _____
 Sec. 7 Twp. 21 Rgs. 3E
 Company Milton Unger
 Farm Name Warkentin No. 2

TOPS	DEPTH	LOG	DATUM
Anh.			
Tp.			
H.			
Tr.			
Dg.			
Bl.			
L.			
K.C.			
B.K.C.			
Ce.			
C.			
M.			
M.			
K.			
Mz.			
Mq.			
V.			
S.			
S.			
A			
R.			
Pe.			
G.			
T.D.			

Loc. in Sec. _____
NE NE SE
 Geol. _____
 Contr. E.K. Carey
 Pool _____
Unger

FIRST REPORT
 SEP 4 '51

Date Comm. RURT

(Large handwritten scribble)

Co.
Lse.
No.
Sec.
T.
R.

County Marion Elev. 1436
 Sec. 7 Twp. 21 Rge. 3E
 Company Milton Unger
 Farm Name Warkentin No. 2-A

TOPS	DEPTH	LOG	DATUM	Loc. in Sec.
Anh.				NE NE SE
Tp.				
H.				
Tr. <u>M12</u>	<u>2827</u>			
Dg. <u>Hunt</u>	<u>2828</u>			
Bl.				
L.	<u>2004</u>			
K.C.				Geol.
B.K.C.				Contr.
Ce.				<u>E.K. Carey</u>
C.				
M.	<u>2567</u>			Pool
M.				<u>Unger</u>
K.				
Mz.				
Ma.				
V.				
S.				
S.				
A.				
R.				
Pe.				
G.				
T.D.	<u>2831</u>			

COMPLETE
 OCT 23 '37

Date Comm.
RURT SEP 11 '37 9-2-57 8 134/110
H 2660 SEP 18 '37 5" 2827
CO 2831 & 3 1/2 BOPH 500A
& 24 BOPH 200' off Bottom
POP SEP 25 '37 OCT 2 '37 OCT 9 '37 OCT 16 '37
PH4 178 BD NW
9N 37°
HUNT 2827-31