

Marion

KANSAS  
3E

SECTION 7 TOWNSHIP 21 RANGE 3E

WELL NO. #1 Wohlgenouth (Wohlgemuth)

COMPANY Milton Unger

NORTH

						0	

WEST

EAST

SOUTH

Marion

KANSAS

SEC.	TWP.	R.
7	21	3E

WELL NO.

#1 Wohlgenouth

FARM

COMPANY

Milton Unger

CONTRACTOR

Carey

SW Unger


\_\_\_\_\_ Ft. from N. Line

\_\_\_\_\_ Ft. from S. Line

\_\_\_\_\_ Ft. from E. Line

\_\_\_\_\_ Ft. from W. Line

NW SE SE

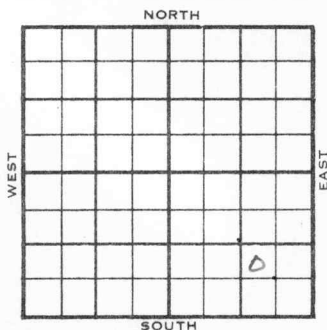

1956	ELEVATION 1414'	REPORT
------	--------------------	--------

5-9 Comm. 5-3-56  
8" @ 123  
Drlg. 2160

7-11 5½" @ 2804  
CO 2806  
B/ 14½ GO  
FU 1075' oil / 12 GW in 15 hrs.,  
P/ 75 BO, no/wtr., 18 hrs.  
P/ 52 BOPD / 40% wtr.  
L. 1988'; M. 2550'; K. 2646';  
Hunt 2803'  
TD 2806'

COMPLETED



County Marion Elev. 1414  
 Sec. 7 Twp. 21 Rge. 3E  
 Company Milton Unger  
 Farm Name Wohlgenouth No. 1

Co.

TOPS	DEPTH	LOG	DATUM	Loc. in Sec.
Anh.				NW SE SE
Tp.				
H.				
Tr.				
Dg.				
Bl.				
L.	<u>1988</u>			
K.C.				Geol.
B.K.C.				Contr.
Ce.				<u>Carey</u>
C.				
M.	<u>2550</u>			
M.				Pool
K.	<u>2646</u>			<u>SW Unger</u>
M. <u>Hunt</u>	<u>2803</u>			
Mq.				
V.				
S.				
S.				
A.				
R.				
PE.				
G.				
TD.	<u>2806</u>			

L. Sec.

COMPLETE

No.

Date Comm. 5-3-56 JUL 1 1 1956

Sec.

8" @ 123 drlg. 2160 MAY 16 '56 5 1/2 @

2804 MAY 23 '56 CO 2806 14 1/2

GO FU 1075' oil + 12 GW in

15 hrs T&R MAY 29 '56 JUN 6 '56

P 75 BO - PW / 18 hrs JUN 13 '56

JUN 20 '56 JUN 27 '56 JUL 3 '56 JUL 11 '56 Ph P.

52 Bord + 40 % wtr

T.

R.