


DX 78-1 Marion

KANSAS

Section 7 Township 21 Range 5E

Well No. #1 Collins

Company Bowman & Grissmore

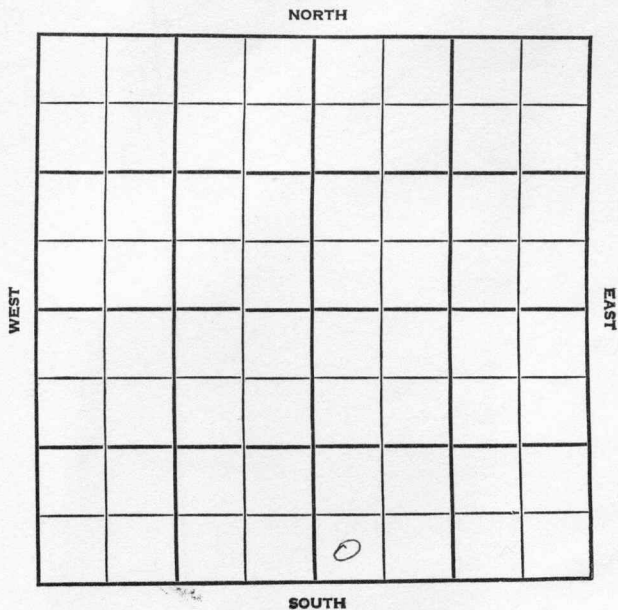

Marion

KANSAS

SEC. 7	TWP. 21	R. 5E
-----------	------------	----------


WELL NO. #1 Collins FARM

COMPANY Bowman & Grissmore

CONTRACTOR White & Ellis

Semi-Wildcat

_____ FT. FROM N. LINE
 _____ FT. FROM S. LINE
 _____ FT. FROM E. LINE
 _____ FT. FROM W. LINE

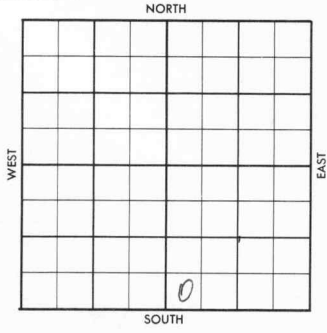

SW SW SE

1956	ELEVATION	REPORT
------	-----------	--------

7-25 Comm. 7-16-56
 8" @ 112 w/100
 Drlg. 1943'
 L. 1614'; KC 1761';

8-1 D & A
 KC 1854'; BKC 1970' M. 2139';
 M. Li. 2170'; K. 2200'; Hunt 2342';
 V. 2366'; S. 2446'; S. Sd. 2497';
 A. 2512';
 TD 2602'

ABANDONED

County Marion Elev. _____
 Sec. 7 Twp. 21 Rge. 5E
 Company Bowman & Grissmore
 Farm Name Collins No. 1

TOPS	DEPTH	LOG	DATUM	Loc. in Sec.
Anh.				SW SW SE
T.p.				
H.				
Tr.				
Dg.				
B.L.				
L.	1614			Geol. _____
K.C.	1761			Contr. _____
B.K.C.				
Ce.				White & Ellis
C.				
M.				Pool
M.				Semi-Wildcat
K.				
Mz.				
Me.				
V.				
S.				
S.				
A.				
R.				
Pe.				
G.				
T.D.				

FIRST REPORT
 JUL 25 1956

Date Comm. 7-16-56
8" @ 112/100 drlg. 1943

AUG 1 1956

R.G.

Co.

Use

No.

Sec.

T.

R.

County Marion Elev. _____
 Sec. 7 Twp. 21 Rge. 58
 Company Lowman & Grissmore
 Farm Name Collins No. 1

TOPS	DEPTH	LOG	DATUM
Ans.			
Tp.			
H.			
Tr.			
Dg.			
Bl.			
L.			
K.C. <u>1854</u>	<u>1611</u>		
B.K.C. <u>1970</u>	<u>1970</u>		
Ce.			
C.			
M. <u>2139</u>	<u>2139</u>		
M. <u>L1</u>	<u>2170</u>		
K. <u>2200</u>	<u>2200</u>		
Mz. <u>Hunt</u>	<u>2342</u>		
Mq.			
V. <u>2366</u>	<u>2366</u>		
S. <u>2446</u>	<u>2446</u>		
S. <u>sd</u>	<u>2497</u>		
A. <u>2512</u>	<u>2512</u>		
R.			
Pe.			
G.			
T.D. <u>2602</u>	<u>2602</u>		

Loc. in Sec. SW QW SE
 Geol. _____
 Contr. White & Ell
 Pool Semi-Wildcat



Date Comm. 7-16-56 AUG 1 1956

8" 112/100 drls. 1943 AUG 1 '56

D & R

Co.
 Use
 No.
 Sec.
 T.
 R.