


Well No. 1- Richards Farm

*Sheedy Etal.* Company

NORTH

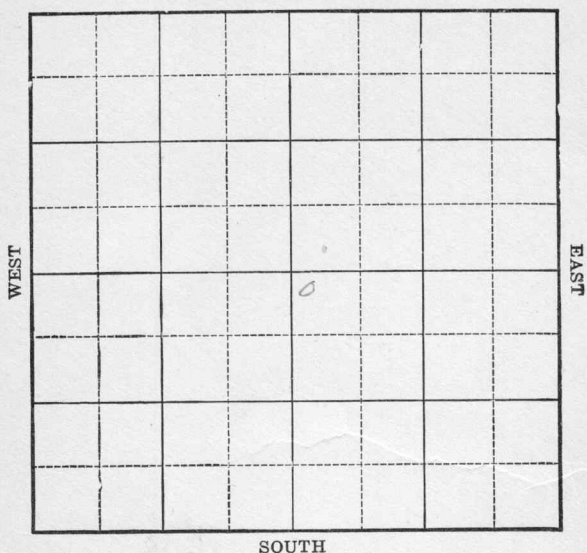

## Rig Up

### Drilling Remarks

## PRODUCTION

1st 24 hrs. Nat.-----

1st 24 hrs. after shot\_\_\_\_\_

Gas \_\_\_\_\_ cu. ft.


Dry Hole -----

Abandoned .....

Map No. Kansas Sec. 7 Twp. 21 R. 10Well No. 1 Richards FarmSheedy et al Company330 Ft. from N. Line

\_\_\_\_\_ Ft. from S. Line

\_\_\_\_\_ Ft. from E. Line

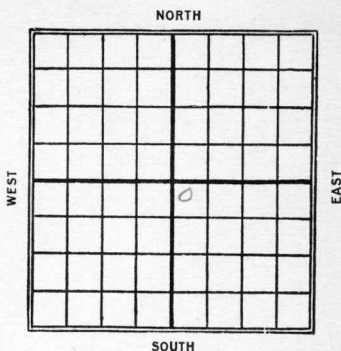330 Ft. from W. Line

Date

REPORT

19264/14 Location4/21 Rig on ground4/28 Rig5/8 Rig5/14 Dlg 400'5/19 " 750'6/2 S.D. 1800'6/10 U.R. 8" 2030'6/18 sand 2298-2352,

show gas, Dlg. 2325'

6/24 D. & A. 2420'

Map No. K21 KANSAS Sec. 7 Twp. 21 R. 10

Well No. 1 Richards  
Shedy et al Company

Contractor

## COMPLETED

## SECTION PLAT

320 Ft. from N. Line

\_\_\_\_\_ Ft. from S. Line

\_\_\_\_\_ Ft. from E. Line

330 Ft. from W. Line

## ABANDONED

|  |  |   |  |
|--|--|---|--|
|  |  |   |  |
|  |  |   |  |
|  |  | o |  |
|  |  |   |  |

Location \_\_\_\_\_

Rig up \_\_\_\_\_

Drilling and Remarks:

Sand 2298-2352

Show 500

Top line 2420

116 2420

## RECORD

Cased \_\_\_\_\_ in., \_\_\_\_\_ ft.

Sand \_\_\_\_\_

Gas \_\_\_\_\_

Oil \_\_\_\_\_

Total Depth 2420

## PRODUCTION

1st 24 hrs. Nat. \_\_\_\_\_

1st 24 hrs. after shot \_\_\_\_\_

Gas \_\_\_\_\_ Cu. Ft.

Dry Hole ☒ \_\_\_\_\_

Abandoned ☒ \_\_\_\_\_

Date

JUN 24 1926

192

CHAS. L. SHERWOOD

Scout

Map No. *K21* **KANSAS** Sec. *7* Twp. *21* R. *10*

Well No. *1* *Richards*

*Sheedy et al* Company

Contractor

## FIRST REPORTS

*330* Ft. from N. Line

Ft. from S. Line

Ft. from E. Line

*330* Ft. from W. Line

## SECTION PLAT

|  |  |   |  |
|--|--|---|--|
|  |  |   |  |
|  |  |   |  |
|  |  | o |  |
|  |  |   |  |

Location ☒

Rig up

Drilling and Remarks:

## RECORD

Cased \_\_\_\_\_ in., \_\_\_\_\_ ft.

Sand \_\_\_\_\_

Gas \_\_\_\_\_

Oil \_\_\_\_\_

Total Depth \_\_\_\_\_

## PRODUCTION

1st 24 hrs. Nat. \_\_\_\_\_

1st 24 hrs. after shot \_\_\_\_\_

Gas \_\_\_\_\_ Cu. Ft.

Dry Hole \_\_\_\_\_

Abandoned \_\_\_\_\_

Date

APR 14 1926

192

CHAS. L. SHERWOOD

Scout