

Map No. 22 Sec. 19 Twp. 21 R. 8
 Well No. 1 Hoover Company

Contractor

FIRST REPORTS

SECTION PLAT

660 Ft. from N. Line
660 Ft. from S. Line
660 Ft. from E. Line
 _____ Ft. from W. Line

			o

Location ✓

Rig up _____

Drilling and Remarks:

RECORD

Cased _____ in., _____ ft.
 Sand _____
 Gas _____
 Oil _____
 Total Depth _____

PRODUCTION

1st 24 hrs. Nat. _____
 1st 24 hrs. after shot _____
 Gas _____ Cu. Ft.
 Dry Hole _____
 Abandoned _____

Date

JUN 26 1925 CHAS. L. SHERWOOD
 192 _____ Scout

Map No. 22 Sec. 19 Twp. 21 R. 8
 Well No. 1 Hoover Company

Contractor

SECTION PLAT

660 Ft. from N. Line
 _____ Ft. from S. Line
660 Ft. from E. Line
 _____ Ft. from W. Line

			o

CORRECTION

Location _____

Rig up Blag

Drilling and Remarks:

chg ownership to
Hoover.

RECORD

Cased _____ in., _____ ft.
 Sand _____
 Gas _____
 Oil _____
 Total Depth _____

PRODUCTION

1st 24 hrs. Nat. _____
 1st 24 hrs. after shot _____
 Gas _____ Cu. Ft.
 Dry Hole _____
 Abandoned _____

Date


JUL 24 1925 CHAS. L. SHERWOOD
 192 _____ Scout

Chase Co
 K-22
 Map No. KANSAS Sec. 19 Twp. 21 R. 8
 Well No. 1 5005
Arkansas Fuel Oil Company

Contractor

COMPLETED

SECTION PLAT

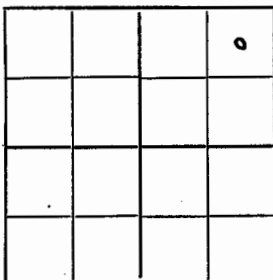

660 Ft. from N. Line
 _____ Ft. from S. Line
660 Ft. from E. Line
 _____ Ft. from W. Line

ABANDONED

Location _____

Rig up _____

Drilling and Remarks:

Tap line 2430'
dry & no
L.D. 2600'

RECORD

Cased _____ in., _____ ft.

Sand _____

Gas _____

Oil _____

Total Depth 2600'

PRODUCTION

1st 24 hrs. Nat. _____

1st 24 hrs. after shot _____

Gas _____ Cu. Ft.

Dry Hole ☒Abandoned ☒

Date

OCT 29 1925 CHAS. L. SHERWOOD Scout


Map No. Kansas Sec. 19 Twp. 21 R. 8
 Well No. 1 Kirk Farm
Hoover et al Company
Arkansas Fuel Oil

660 Ft. from N. Line

_____ Ft. from S. Line

660 Ft. from E. Line

_____ Ft. from W. Line

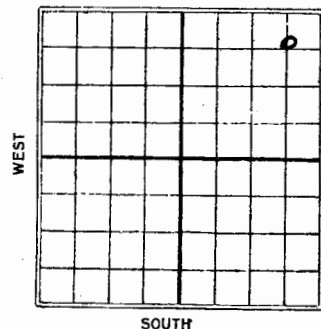

REPORT

Date	REPORT
1925	
6/26	Location
7/3	
7/17	
7/24	Bldg. Rig.
7/31	Rig
8/7	Spud.
8/14	Spud.
8/19	520'
8/26	1190'
9/3	1500'
9/11	U.R. 10" to 1500'
9/16	Qty @ 1600'
9/24	✓ 2000'
10/1	✓ 2200'
10/8	✓ 2375'
10/16	o.d. @ 2430'
10/22	Tap Line 2430' Dalg @ 2480'
	o.d. 2425' 14' sand at base
10/29	Abandoned 2600'

