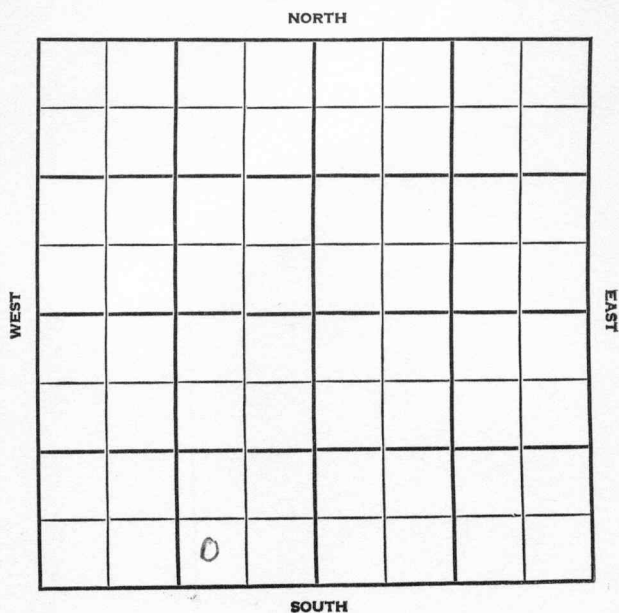


Section 8 Township 21 Range 3 EWell No. #3 LoewenCompany Cities Service

Marion

KANSAS

SEC. 8	TWP. 21	R. 3E
------------------	-------------------	-----------------

WELL NO.

#3 Loewen

FARM

COMPANY

Cities Service

CONTRACTOR

White & Ellis


_____ Ft. from N. Line

_____ Ft. from S. Line

_____ Ft. from E. Line

_____ Ft. from W. Line

SW SE SW

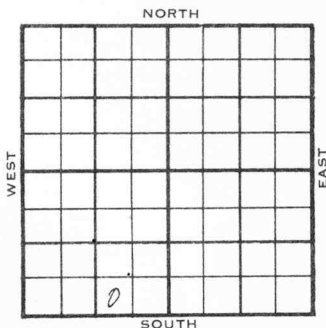

1956

ELEVATION

1403

REPORT

2-22

Comm. 2-18-56

8" @ 128/120

Drlg. 2160

3-21

DST 2805-10 op 1 hr. rec. 3' mud,
780/20"DST 2810-17 op 1 hr. rec. 3' oil, 60'
sw, 950/20"DST 2839-43 op 1 hr. rec. 20' mud, 0#
5½" @ 3054/800

CO to 3475

Comp. SWD well.

Dg. sd. 1763

L. 1975

KC 2105

BKC 2349

M. 2546

M. Base 2670

Mz. 2803

Hunt 2804

V. 2838

S. sd. 2924

A. 2992

TD 3475'

ABANDONED

County Marion Elev. _____
 Sec. 8 Twp. 21 Rge. 3E
 Company Cities Service
 Farm Name Loewen No. 3

TOPS	DEPTH	LOG	DATUM
Anh.			
TP.			
H.			
Tr.			
Dg.			
Bl.			
L.			
M.C.			
B.K.C.			
Ce.			
C.			
M.			
M.			
K.			
Mz.			
Mq.			
V.			
S.			
S.			
A			
R.			
PE.			
G.			
T.D.			

Loc. in Sec. _____

SW SE SW

Geol. _____

Contr. _____

White & Ellis

Pool _____

	FEB 22 '56	

FIRST REPORT

Date Comm. 2-18-56
8" @ 128/125 drlg. 2160

Co.

L.S.

No.

Sec.

T.

R.

County Marion Elev. 1403
 Sec. 8 Twp. 21 Rge. 3E
 Company Cities Service
 Farm Name Loeven No. 3

TOPS	DEPTH	LOG	DATUM	Loc. in Sec.
Anh.				SW SE SW
Tr.				
H.				
Tr.				
Dg. <u>sd</u>	<u>1763</u>		<u>360</u>	
BL.				
L.	<u>1975</u>		<u>572</u>	Geol.
K.C.	<u>2105</u>		<u>702</u>	Contr.
B.K.C.	<u>2349</u>		<u>946</u>	<u>White & Ellis</u>
Ce.				
C.				
M.	<u>2546</u>		<u>1143</u>	Pool
M. <u>Base</u>	<u>2670</u>		<u>1276</u>	
K.				
Mz.	<u>2803</u>		<u>1400</u>	
Mo. <u>Hunt</u>	<u>2804</u>		<u>1401</u>	
V.	<u>2838</u>		<u>1435</u>	
S. <u>sd</u>	<u>2924</u>		<u>1521</u>	
S.				
A.	<u>2992</u>		<u>1589</u>	
R.				
Pe.				
G.				
T.D.	<u>3475</u>			

Date Comm. 2-18-56 MAR 21 1956
8" @ 128/120 DST 2805-10 open 1 hr.

rec. 3' mud 780/20" DST 2810-17
 open 1 hr. rec. 3' oil 60' sw 950/20"
 DST 2839-43 open 1 hr. rec. 20' mud
 O# 5 $\frac{1}{2}$ " @ 3054/800 CO to 3475
 Comp. SWD well.

ABANDONED