

DX 781

O.W.W.O.

Marion


KANSAS

Section 8 Township 21 S Range 3 E

Well No. # 1 Unger

Company C. Carlock

NORTH

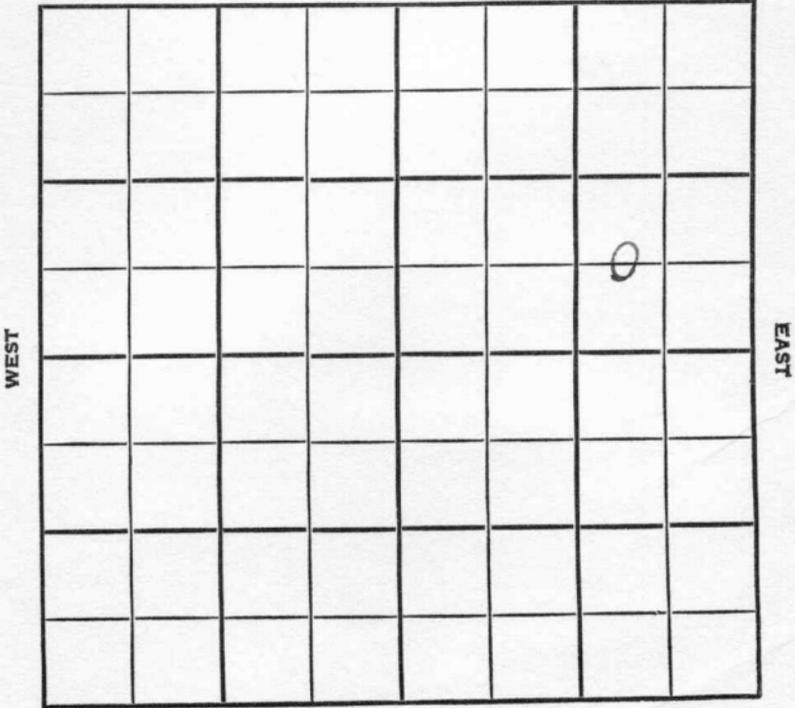

SOUTH

WEST

EAST

O.W.W.O.

Marion

KANSAS

SEC. 8	TWP. 21S	R. 3E
-----------	-------------	----------


WELL NO. #1 Unger FARM

COMPANY C. Carlock

CONTRACTOR Bedell-Catt Tools.

~~Wildcat.~~ Unger

_____ Ft. from N. Line
 660 _____ Ft. from S. Line
 990 _____ Ft. from E. Line
 _____ Ft. from W. Line

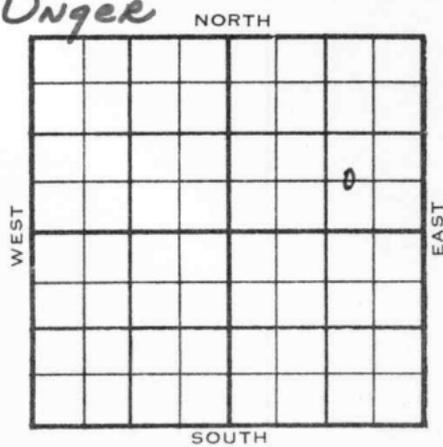

CW / 2 SE NE

1954 ELEVATION --- 1400' REPORT

12/8

MIRT

12/22

Spud 12-9-54 D & A TD 2525
 8" @ 150 Tor. 1705 Doug. 1716
 Lans 1953 Miss 2515
 DST 2516-25 open 1 hr rec 30' oily
 mud, 300' SW 500# TD 2525
 D & A

ABANDONED

1955
 11/16

O.W.W.O.

OTD 2525'
 8" @ 150 DD TD 2802'
 5" @ 2799'
 L. 1953', M. 2515', K. 2638', Mz 2790
 Hunton 2799'

12-14

CO to 2802
 FU 2400' oil 3 hrs.
 Comp. 115 bopd
 TD 2802'

COMPLETED

County Marion State Kansas

Sec. 8 (Blk.) 21S (Sur.) 3E Map No.

Operator C. Carlock

Well No. 1 Farm Unger

Elev. Location CW/2 SE NE

660 Ft. From S Line

990 Ft. From E Line NE Quarter

Ist. Report DEC 8 1954

Completion

Remarks Bedell-Catt tools

Spudding Date

Drlg. Data Wildcat

MIRT

FABEN GILSTRAP

O.W.W.O.

FORM 513 REV. SUNRAY

O.W.W.O.

County Marton Elev. 1400 Co. _____
 Sec. 8 Twp. 21 Rge. 3E
 Company Chas. Carlock
 Farm Name Unger No. 1

TOPS	DEPTH	LOG	DATUM	Loc. in Sec.
Anh.				C W $\frac{1}{2}$ SE NE
Tp.				
H.				
Tr.				
Dg.				
Bl.				
L.	1953			
K.C.				Geol. _____
B.K.C.				Contr. _____
Ce.				
C.				
M.	2515			
M.				Pool _____
K.	2638			Unger
Mz.	2798			
Me.	Hunton 2799			
V.				
S.				
S.				
A.				
R.				
PE.				
G.				
T.D.				

FIRST REPORT
 NOV 16 1955

Date Comm. 8" @ 150 OTD 2525 DD TD 2802
5" @ 2799

Co.
Lse.
No.
Sec.
T.
R.

