

Marion


KANSAS

SECTION 8 TOWNSHIP 21 RANGE 3 E

WELL NO. #1 Unger

COMPANY C. L. Carlock

NORTH

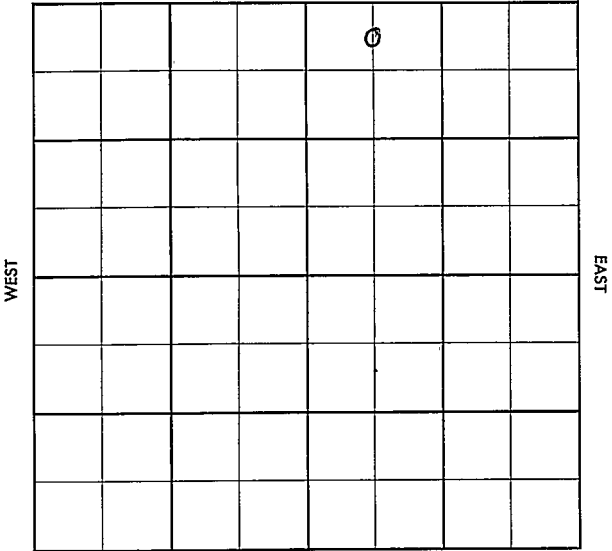

SOUTH

Marion

KANSAS

SEC.	TWP.	R.
8	21	3E

WELL NO.

#1 Unger

FARM

COMPANY

C.L. Carlock

CONTRACTOR

Bedell & Catt


Unger

_____ Ft. from N. Line

_____ Ft. from S. Line

_____ Ft. from E. Line

_____ Ft. from W. Line

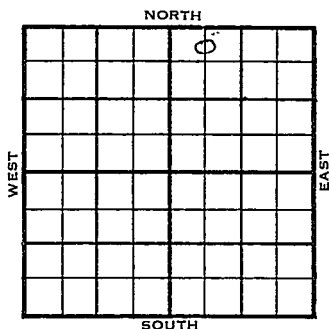C N $\frac{1}{2}$ NW NE

1956	ELEVATION	REPORT
	1413	
1-5	MIR	
1-18	Comm. 1-3-56 8 5/8" @ 98/90 Cored. 2800-29 rec 29' D & A L. 1974 BKC 2340 C. 2534 Chat 2541 K. 2655 Chatta sh. 2814 Mz. 2816 Hunton 2817 Mag 2824 Viola 2863 TD 2894'	
		ABANDONED

County Marion Elev. _____
 Sec. 8 Twp. 21 Rge. 3E
 Company G. L. Garlock
 Farm Name Unger No. 1

TOPS	DEPTH	LOG	DATUM	Loc. in Sec.
Anh.				C N$\frac{1}{2}$ NW NE
Tr.				
H.				
Tr.				
Dg.				Geol. _____
Bl.				Contr. _____
L.				Bedell & Cat
K.C.				
B.K.C.				Pool _____
Ce.				Unger
C.				
M.				JAN 5 '56 FIRST REPORT
M.				
K.				
Mz.				
Me.				
V.				
S.				
S.				
A.				
R.				
Pe.				
G.				
T.D.				

Date Comm.

M I R

18

County Marion Elev. 1413 Co. 1
 Sec. 8 Twp. 21 Rge. 3E
 Company C. L. Carlock
 Farm Name Unger No. 1

TOPS	DEPTH	LOG	DATUM
Anh.			
Tr.			
H.			
Tr.			
Dg.			
BL.			
L.	1974		561
K.C.			
B.K.C.	2340		927
Ce.			
C.	2534		1121
M.	2541		1128
M.			
K.	2655		1242
Mz. (Hatta sh)	2814		1401
Mq.	2816		1403
V.	2817		1404
S.	2824		1411
S. (Violin)	2863		1450
A.			
R.			
PE.			
G.			
T.D.	2894		

Loc. in Sec.

C N¹/₂ NW NE

Geol.

Contr.

Bedell & Cat

Pool

Unger

ABANDONED

Date Comm. 1-3-56

JAN 18 1956

8 5/8" @ 98/90 cored 2800-29

rec. 29'

D & A