

KANSAS


Form 51—5M—7-40—Palace

Marion

Section 9 Township 21 Range 3-E

Well No. #1 Janzen

Company Basinger & Fowler

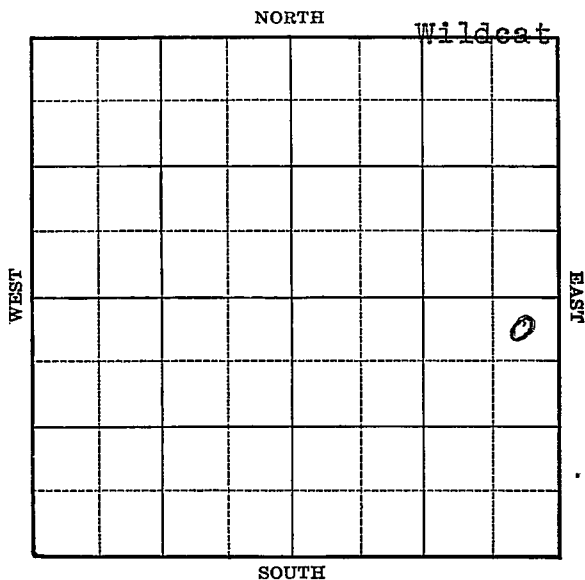


Sec. 9 Twp. 21 R. 3-EWell No. #1 Janzen FarmBasinger & Fowler Company

(Wildcat)

330 Ft. from N. Line Ft. from S. Line330 Ft. from E. Line Ft. from W. Line

Elev. 1404

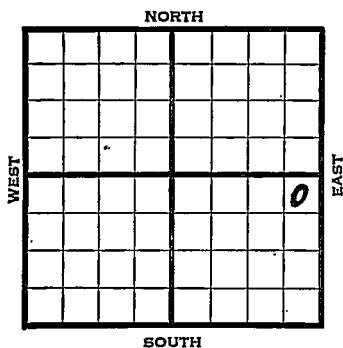

1940	REPORT	
11/20	Location	4/18 Machine.
11/27	"	4/24 "
12/5	"	5/1 "
12/12	Machine.	5/8 Spud.
12/19	"	5/22 Shut down.
12/26	"	5/28 " "
1941		6/5 " "
1/2	"	6/12 " "
1/9	"	6/19 12" - 50'
1/16	"	Drilg. 70'
1/23	"	6/26 SD 70'
1/30	"	7/3 "
2/6	"	7/10 "
2/13	"	7/17 12" - 55'
2/20	"	Drilg. 150'
2/27	"	m7/24 " "
3/6	"	7/31 SD 480'
3/13	"	8/7 Drilg. 675'
3/20	"	8/15 T.D. 1050
3/27	"	8/21 10" - 1044'
4/3	"	T.D. 1085'
4/10	"	OVER

1941				
8/28	10" - 1044'			
	TD 1085'			
9/4	Shut down.			
9/11	8" - 1200'			
	Drlg. 1560'			
9/18	SD 1560'			
9/25	"			
10/2	"			
10/9	Drlg. 1900'			
10/16	8" - 1525'	K.C. 1925'		
	T.D. 1930'	C.O.		
10/23	"	"	"	
10/30	7" - 1700'	Drlg. 2250'		
11/6	Shut down 2250'			
11/13	Miss. 2506'	T.D. 2526'		
	H.F.W. 6" - 1950'	U.R.		
11/20	6" - 2090'	T.D. 2526'		
	Shut down.			
11/28	"	"		
12/4	"	"		
12/11	"	"		
12/18	"	"		
12/24	2525'	U.R. 6".		
12/31	SD for engine repairs.			
1942				
1/8	"	"	"	"
1/15	"	"	"	"
1/22	"	"	"	"
1/29	6" - 2556'	T.D. 2565'	6" leaks.	
	Pulling 6".			
2/5	"	"		
2/12	6" - 2565'	C.O.		
2/19	"	"	"	
2/26	"	"	"	
3/5	"	"	"	
3/12	"	"	"	
3/19	"	"	"	

OVER

1942
3/26 8" - 2565' C.O.
4/2 6" - 2568' Miss. 2590'
Drlg. 2605'
4/8 " "
4/15 5" - 2766' T.D.
Shut down.
4/22 Kind. ~~2809~~²⁶⁴⁰ S.S.O. 2814'
5" - 2810' T.D. 2837' C.O.
4/29 " " "
5/6 Drlg. 2949'
5/13 Drlg. 3015'
5/20 Kind. 2640' (Corrected)
Viola 2840' Simp. 2928' Arb. 2970'
T.D. 3032' SD.
5/27 " "
6/3 Pull all casing except 6".
P.B. to 2525' 6" - 2506'
6/10 " " "
6/17 " " "
6/24 " " "
7/2 " " "
7/8 " " "
7/15 " " "
7/22 " " "
7/29 " " "
8/5 Arb. 2970' water.
T.D. 3032'

ABANDONED

County _____

State _____


Section _____

Survey

Block _____

Well No. _____ Farm _____

Company_____

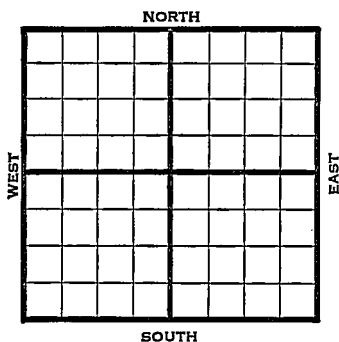

_____ Ft. N. Line

Ft. S. Line

_____ Ft. E. Line

_____ Ft. W. Line

[illegible]

Map No. 24 Sec. 9 Twp. 21 R. 3EWell No. 1 JanzenBasinger & Fowler

Company

Contractor

FIRST REPORT

NE SE

330 Ft. from N. Line Ft. from S. Line330 Ft. from E. Line Ft. from W. Line

WILDCAT

SECTION PLAT

			o

Location XRig up

Drilling and Remarks:

RECORD

Cased in., ft.Sand Gas Oil Total Depth

PRODUCTION

1st 24 hrs. Nat. 1st 24 hrs. after shot Gas Cu. Ft.Dry Hole Abandoned

Date

NOV 20 1940

19

S. J. LEWIS

Scout

Misc Small Maps	
Cards	
Tracing	
France Map	

Marion

KANSAS

Map No. 24 Sec. 9 Twp. 21 R. 3EWell No. 1 JanzenBasinger & Fowler CompanyABANDONED Contractor

NE SE

SECTION PLAT

			o

330 Ft. from N. Line Ft. from S. Line330 Ft. from E. Line Ft. from W. Line

WILDCAT

Location Rig up

Drilling and Remarks:

Cr Y2970Water

RECORD

Cased in., ft.Sand Gas Oil Total Depth 3032

PRODUCTION

1st 24 hrs. Nat. 1st 24 hrs. after shot Gas Cu. Ft.Dry Hole Abandoned

Date

AUG 5 1942 19 S. J. LEWIS Scout

Misc. Small Maps
Cards
Tracing
France Map
Scarborough
Moody Map
Geological Dept.
Moody Flat Book