


Map No. Kansas Sec. 9 Twp. 21 R. 13 Lyon Co

Well No. 1 O'Conner Farm \_\_\_\_\_  
Fisher Oil Company

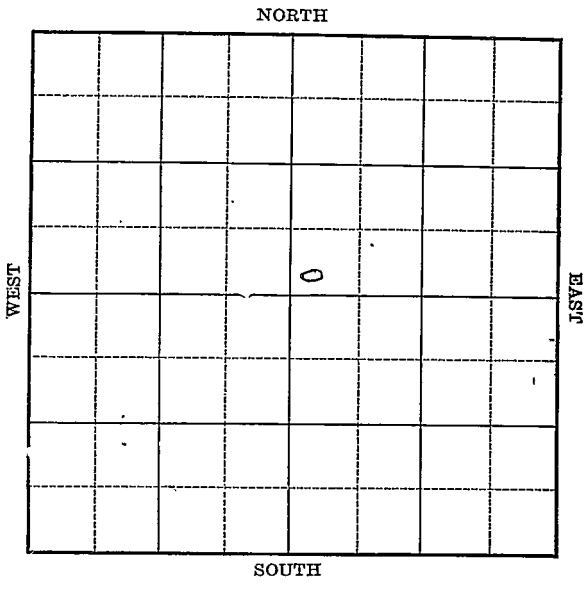

Location \_\_\_\_\_

Drilling Remarks \_\_\_\_\_

\_\_\_\_\_

\_\_\_\_\_

Rig Up \_\_\_\_\_

Drilling Remarks \_\_\_\_\_

\_\_\_\_\_

\_\_\_\_\_

**RECORD**

Cased \_\_\_\_\_ in. \_\_\_\_\_ ft.

Sand \_\_\_\_\_

Gas \_\_\_\_\_

Oil \_\_\_\_\_

Total Depth \_\_\_\_\_

**PRODUCTION**

1st 24 hrs. Nat. \_\_\_\_\_

1st 24 hrs. after shot \_\_\_\_\_

Gas \_\_\_\_\_ cu. ft.

Dry Hole \_\_\_\_\_

Abandoned \_\_\_\_\_


Lyon Co

Map No. Kansas Sec. 9 Twp. 21 R. 13

Well No. 1 O'Conner Farm

Fisher Oil Company

NORTH

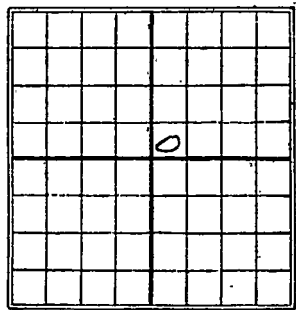

\_\_\_\_\_ Ft. from N. Line

200 Ft. from S. Line

\_\_\_\_\_ Ft. from E. Line

200 Ft. from W. Line

Date

REPORT

1925

12/3 machine

12/10

12/17 Dlg 400'

12/23 set 9 1/2" 450' S.D.

12/31

1926

1/8 S.D. 762' tools in hole.

1/14

1/20

1/27 S.D. 1185'

2/4 Dlg 1200'

2/10 S. & G. 1831

*Lyon Co*

Map No. <sup>*Wm map*</sup> **KANSAS** Sec. *9* Twp. *21* R. *13*

Well No. *1 O'Connor*

*Fisher Oil Co* Company

Contractor

**SECTION PLAT**

		o	

\_\_\_\_\_ Ft. from N. Line

*200* Ft. from S. Line

\_\_\_\_\_ Ft. from E. Line

*200* Ft. from W. Line

**FIRST REPORTS**

Location \_\_\_\_\_

Rig up *"Mac line"*

Drilling and Remarks:

**RECORD**

Cased \_\_\_\_\_ in., \_\_\_\_\_ ft.

Sand \_\_\_\_\_

Gas \_\_\_\_\_

Oil \_\_\_\_\_

Total Depth \_\_\_\_\_

**PRODUCTION**

1st 24 hrs. Nat. \_\_\_\_\_

1st 24 hrs. after shot \_\_\_\_\_

Gas \_\_\_\_\_ Cu. Ft.

Dry Hole \_\_\_\_\_

Abandoned \_\_\_\_\_

Date

DEC 3 1925

**CHAS. L. SHERWOOD**

192

Scout




Contractor

**COMPLETED**

**SECTION PLAT**

----- Ft. from N. Line

*200* Ft. from S. Line

----- Ft. from E. Line

*200* Ft. from W. Line

		0	

**ABANDONED**

Location -----

Rig up -----

Drilling and Remarks:

*Top line 1800'*  
*1st Break 1825'*  
*1830'*  
*Dry a wk.*

**RECORD**

Cased ----- in., ----- ft.

Sand -----

Gas -----

Oil -----

Total Depth *1831'*

**PRODUCTION:**

1st 24 hrs. Nat. -----

1st 24 hrs. after shot -----

Gas ----- Cu. Ft.

Dry Hole  -----

Abandoned  -----

Date

**FEB 10 1926**

**CHAS. L. SHERWOOD**

192

Scout