

Marion

KANSAS

9


21

5E

SECTION \_\_\_\_\_ TOWNSHIP \_\_\_\_\_ RANGE \_\_\_\_\_

WELL NO. #1 H.D. Soper

COMPANY White & Ellis Drlg.

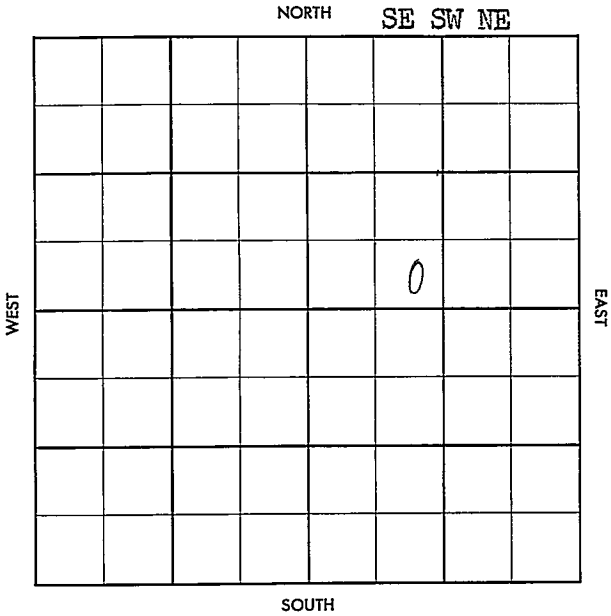

County Marion Elev. 1262  
 Sec. 9 Twp. 21 Rge. 5E  
 Company White & Ellis Drlg.  
 Farm Name H. D. Soper No. 1

TOPS	DEPTH	LOG	DATUM
Anh.			
Tp.			
H.			
Tr.			
Dg.			
Bl.			
L.			
K.C.			
B.K.C.			
Ce.			
C.			
M.			
M.			
K.			
Mz.			
Mo.			
V.			
S.			
S.			
A.			
R.			
PE.			
G.			
TD.			

Loc. in Sec. SE SW NE  
 Geol. \_\_\_\_\_  
 Contr. \_\_\_\_\_  
 Co. Tools \_\_\_\_\_  
 Pool \_\_\_\_\_  
 Unnamed \_\_\_\_\_

MAR 20 '57  
 ABANDONED

Date Comm. 3-12-57  
 SP set w/spdr, WORT

*Old Lee*


Co.  
 Use.  
 No.  
 Sec.  
 T.  
 R.

County Marion Elev. \_\_\_\_\_  
 Sec. 9 Twp. 21 Rgs. 5E  
 Company White & Ellis Drlg.  
 Farm Name H. D. Soper No. 1

TOPS	DEPTH	LOG	DATUM
Anh.			
Tp.			
H.			
Tr.			
Dg.			
Bl.			
L.			
K.C.			
B.K.C.			
Ce.			
C.			
M.			
M.			
K.			
Mz.			
Mo.			
V.			
S.			
S.			
A.			
R.			
Pe.			
G.			
T.D.			

Loc. in Sec. \_\_\_\_\_  
SE SW NE

Geol. \_\_\_\_\_  
 Contr. \_\_\_\_\_  
 Co. Tools \_\_\_\_\_  
 Pool \_\_\_\_\_  
 Unnamed \_\_\_\_\_

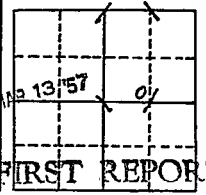

Date Comm. 3-12-57  
SP set w/sodr. WORT

10

Co.  
Lse.  
No. 1  
Sec.  
T.  
R.