

O.W.D.D

NO-RECORD

Section 1 Township 22 Range 3E

Well No. #1 Liptau

Company J.H.Saunders. (Was H.J. Uhl)

NORTH

WEST

EAST

0

SOUTH

O. W. D. D
NO-RECORD

Marion KANSAS

SEC.	TWP.	R.
1	22	3 E

WELL NO.

1 Liptau

FARM

COMPANY

J. H. Saunders (was H. J. Uhl)

CONTRACTOR


_____ Ft. from N. Line

330 _____ Ft. from S. Line

330 _____ Ft. from E. Line

_____ Ft. from W. Line

SE SE SW

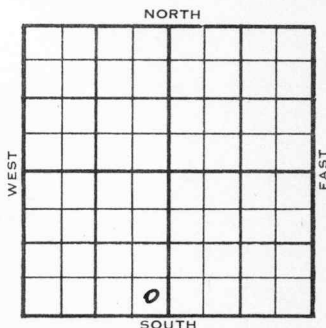

1955

ELEVATION

1403'

REPORT

2/16

O. W. D. D NO-RECORD

SWD well TD 2615' Miss 2455
Kh. 2562' 5" @ 2458 OTD 2566
PB 2469 4½" liner @ 2554 DD 2615
1000 A Comp. SWD well.
Input 40 BSWPH

FIRST REPORT

↓
ABANDONED

NO RECORD
FORM 275 FOR SALE BY KANSAS BLUE PRINT CO.
O. W. D. D

County Marion State Kansas
Sec. 1 (Blk.) 22 (Sur.) 3E Map No.
(Twsp.)
Operator J. H. Saunders (was H. J. Uhl)
Well No. 1 Farm Liptau
Elev. 1403 Location SE SE SW



330 Ft. From S Line SW
330 Ft. From E Line Quarter
1st. Report FEB 1 6 1955
Completion FEB 1 6 1955
Remarks OWDD
O. W. D. D
Spudding Date NO-RECORD

Drlg. Data SWD well TD 2615
Miss. 2455 Kh. 2562 5" @ 2458 OTD 2566
PB 2469 4 1/2" liner @ 2554 DD 2615
1000 A Comp. SWD well Input 40 bswph

no record
NO-RECORD

FABEN GILSTRAP