
FORM 51 25M 8-50 WESTERN Marion KANSAS

Section 1 Township 22 Range 3E

Well No. #1 Fred Cole

Company H. J. Uhl

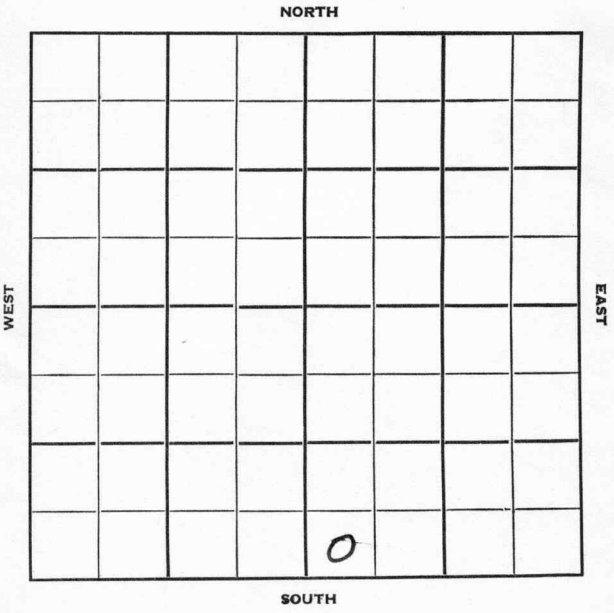

FORM 252-B
10M 10-50 PETROL

Marion KANSAS ✓

Sec. 1 Twp. 22 R. 3 E

Well No. # 1 Fred Cole Farm

H. J. Uhl Company

Contractor


Ft. from N. Line

330 Ft. from S. Line

Ft. from E. Line

330 Ft. from W. Line

SW SW SE

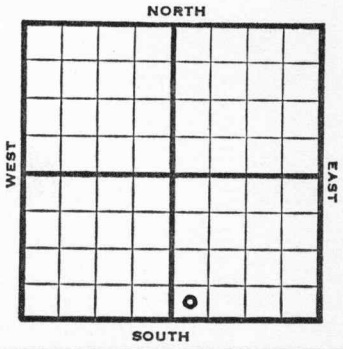

1952	Elev. 1407' REPORT
8/13	Spud 8-10-52 8" @ 90 Drlg. 100'
9/10	Spud 8-10-52 8" @ 90' TD 2735' D&A

ABANDONED

FORM 275 FOR SALE BY KANSAS BLUE PRINT CO.


County Marion State Kansas

Sec. 1 (Blk. Twp.) 22 (Sur. Rge.) 3E Map No.

Operator H. J. Uhl

Well No. 1 Farm Fred Cole

Elev. Location SW SW SE

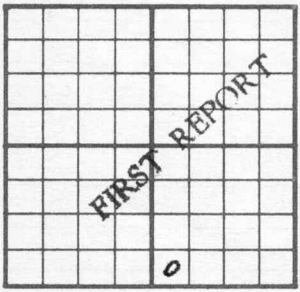

330 Ft. From S Line SE

330 Ft. From W Line Quarter

1st. Report AUG 1 3 1952

Completion

Remarks

Spudding Date 8-10-52

Drlg. Data

8" @ 90 Drlg. 100

J. G. McGEHEE

FORM 275 FOR SALE BY KANSAS BLUE PRINT CO.


County Marion State Kansas

Sec. 1 (Blk. Twp.) 22 (Sur. Rge.) 3E Map No.

Operator H. J. Uhl

Well No. 1 Farm Fred Cole

Elev. 1407 Location SW SW SE

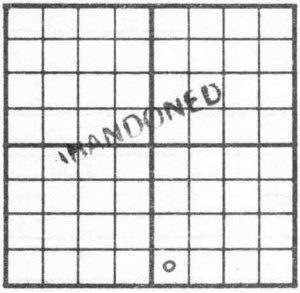

330 Ft. From S Line SE

330 Ft. From W Line Quarter

1st. Report

Completion SEP 10 1952

Remarks

Spudding Date 8-10-52

Drlg. Data

8" @ 90 TD 2735 D & A

J. G. McGEHEE