

KANSAS

Chase

Section 1 Township 22 Range 9E

Well No. 1 Snider

Company Ward McGinnis

Misc.

NORTH

WEST

EAST

SOUTH

9

0

KANSAS

Chase



Sec. 1 Twp. 22 R. 9E

Well No. #1 Snider Farm

Ward McGinnis Company

Miscellaneous


 Ft. from N. Line

1360' Ft. from S. Line

250' Ft. from E. Line

 Ft. from W. Line

C E L SE

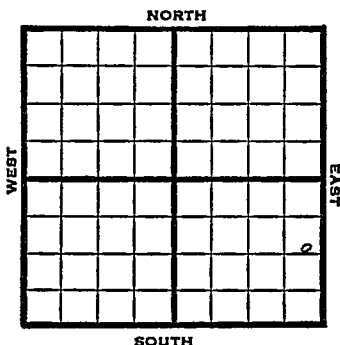

1948	Elev. - REPORT
10/20	RUR
10/26	Dr1g. 2025'
11/3	8"@ 125
	Miss 2325-61'
	TD 2361'
	4"@ 2333'
11/10	"
11/17	Miss 2325'
	4" @ 2333'
	2000 acid
	Pump 30 oil Pot.
	Gr. 38
	TD 2361'
	COMPLETED

Map No. _____ Sec. 1 Twp. 22 R. 9E

Well No. 1 Snider

Ward McGinnis Company

FIRST REPORT Contractor

C E L S E


SECTION PLAT

_____ Ft. from N. Line

1360 Ft. from S. Line

250 Ft. from E. Line

_____ Ft. from W. Line

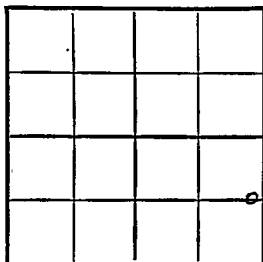

Chase County

Location _____

Rig up _____

Drilling and Remarks:

R U R

RECORD

Cased _____ in., _____ ft.

Sand _____

Gas _____

Oil _____

Total Depth _____

PRODUCTION

1st 24 hrs. Nat. _____

1st 24 hrs. after shot _____

Gas _____ Cu. Ft.

Dry Hole _____

Abandoned _____

Date

OCT 20 1948

19

S. J. LEWIS

Scout

Map No. 22 Sec. 1 Twp. 22 R. 9E

Well No. 1 Snider

Ward McGinnis Company

COMPLETE Contractor

C E L S E


SECTION PLAT

 Ft. from N. Line

1360 Ft. from S. Line

250 Ft. from E. Line

 Ft. from W. Line

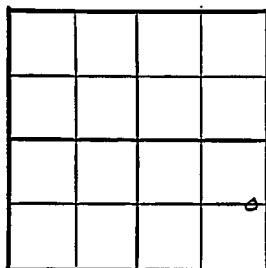

Chase County

Location

Rig up

Drilling and Remarks:

Misc 2225

4" @ 2233

2000 acid

Pump 30 oil Oct

2824

RECORD

Cased in., ft.

Sand

Gas

Oil

Total Depth 3261

PRODUCTION

1st 24 hrs. Nat.

1st 24 hrs. after shot

Gas Cu. Ft.

Dry Hole

Abandoned

Date

NOV 17 1948 19

S. J. LEWIS Scout