


Section 1 Township 22-N Range 10-E

Well No. #1 Hess (Twin)

Company Hess etal

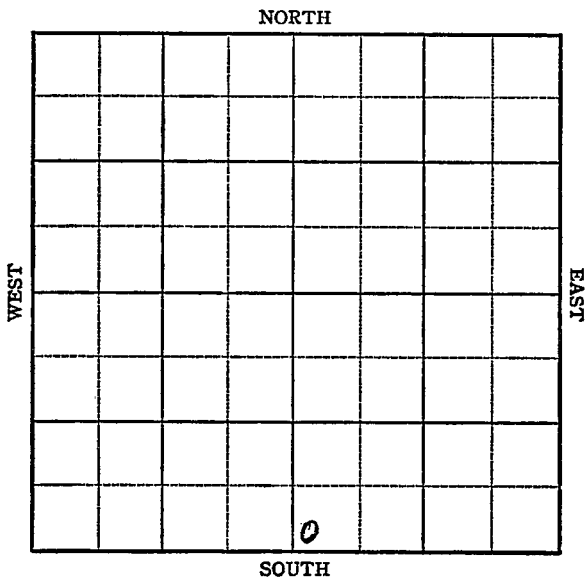

KANSAS

Greenwood



Sec. 1 Twp. 22 R. 10E

Well No. #1 Hess (Twin) Farm

Hess et al Company

Misc.


 Ft. from N. Line

100 Ft. from S. Line

 Ft. from E. Line

100 Ft. from W. Line

SW SE

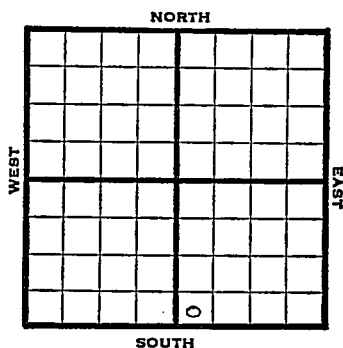

1948

REPORT

2/25

Bart. 2010'

6" @ 1989'

TD 2060'

100 qts. 2010-55'

Pump 15 bbls.

Comp

FIRST REPORT



COMPLETED

Map No. 21 Sec. 1 Twp. 22 R. 10E

Well No. 1 Hess

Hess etal. Company

FIRST REPORT

Contractor

SW SE

COMPLETE


SECTION PLAT

 Ft. from N. Line

100 Ft. from S. Line

 Ft. from E. Line

100 Ft. from W. Line

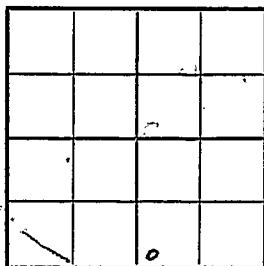

Greenwood County

Location

Rig up

Drilling and Remarks:

twin well
Bart. 2010
6" @ 1989
TD 2060
100 qts. 2010-55
Pump 15 bbl.

RECORD

Cased in., ft.

Sand

Gas

Oil

Total Depth 2060

PRODUCTION

1st 24 hrs. Nat.

1st 24 hrs. after shot

Gas Cu. Ft.

Dry Hole

Abandoned

Date

FEB 25 1948 19 S. J. LEWIS Scout