


Map No. *Kansas* Sec. *1* Twp. *22* R. *10*

Well No. *2. Muller.* Farm

Syndicate oil Company

NORTH

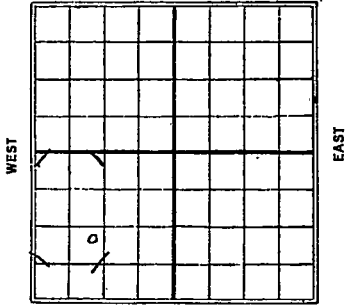

..... Ft. from N. Line

990 Ft. from S. Line

..... Ft. from E. Line

990 Ft. from W. Line

SOUTH

1926.

Date REPORT

5/5 Rign

5/12 —

5/19 —

6/2 Spudding

6/2 Sand # 1967-2036

240 gts 1000 bbls

Sherwood

Map No. **R21 KANSAS** Sec. **1** Twp. **22** R. **10**

Well No. **2 Fulbr**

Syndicate oil Co Company

Contractor

SECTION PLAT

_____ Ft. from N. Line

990 Ft. from S. Line

_____ Ft. from E. Line

990 Ft. from W. Line

FIRST REPORTS

Location _____

Rig up _____

Drilling and Remarks:
Rigging up.

RECORD

Cased _____ in., _____ ft.
 Sand _____
 Gas _____
 Oil _____
 Total Depth _____

PRODUCTION

1st 24 hrs. Nat. _____
 1st 24 hrs. after shot _____
 Gas _____ Cu. Ft.
 Dry Hole _____
 Abandoned _____

Date

MAY 5 1926

192

CHAS. L. SHERWOOD
Scout

K21 KANSAS *Talbenwood*
Map No. _____ Sec. *1* Twp. *22* R. *10*

Well No. *2 Kullon*
Syndicate Oil Co Company

Contractor _____

COMPLETED

SECTION PLAT

_____ Ft. from N. Line

990 Ft. from S. Line

_____ Ft. from E. Line

990 Ft. from W. Line

Location _____

Rig up _____

Drilling and Remarks:

244 / *1000* *ss.*

RECORD

Cased _____ in. _____ ft.

Sand *1967-2036*

Gas _____

Oil _____

Total Depth *2036*

PRODUCTION.

1st 24 hrs. Nat. _____

1st 24 hrs. after shot _____

Gas _____ Cu. Ft.

Dry Hole _____

Abandoned _____

Date

JUN 2 1926

CHAS. L. SHERWOOD

192

Scott