

Chase

Map No. *Kansas* Sec. *1* Twp. *22* R. *9*

Well No. *1 Evans* Farm


White Eagle O. & P. Company

330 Ft. from N. Line

_____ Ft. from S. Line

330 Ft. from E. Line

_____ Ft. from W. Line

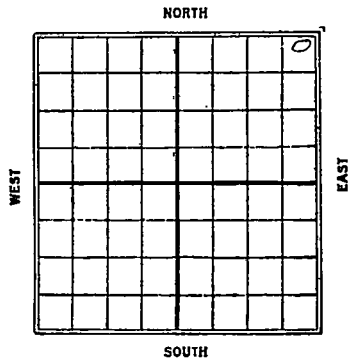

Date	REPORT
<i>1926</i>	
<i>3/18</i>	<i>Location</i>
<i>3/25</i>	_____
<i>4/1</i>	_____
<i>4/7</i>	_____
<i>4/14</i>	_____
<i>4/21</i>	_____
<i>4/30</i>	_____
<i>5/8</i>	<i>Same.</i>
<i>5/14</i>	<i>Same.</i>
<i>5/19</i>	_____
<i>6/7</i>	<i>Same</i>
<i>6/10</i>	_____
<i>6/18</i>	_____
<i>6/25</i>	_____
<i>6-30</i>	_____
<i>7/8</i>	_____
<i>7/14</i>	<i>abandoned location</i>

Chase

Map No. **K22** KANSAS Sec. **1** Twp. **22** R. **9**

Well No. **1** *Guano*

White Eagle Oil Company

Contractor

FIRST REPORTS

SECTION PLAT

330 Ft. from N. Line

Ft. from S. Line

330 Ft. from E. Line

Ft. from W. Line

			o

Location

Rig up

Drilling and Remarks:

RECORD

Cased _____ in., _____ ft.

Sand _____

Gas _____

Oil _____

Total Depth _____

PRODUCTION

1st 24 hrs. Nat. _____

1st 24 hrs. after shot _____

Gas _____ Cu. Ft.

Dry Hole _____

Abandoned _____

Date

MAR 18 1926

CHAS. L. SHERWOOD

192

Scout

Chabe

K22 KANSAS
Map No. _____ Sec. 1 Twp. 22 R. 9Well No. 1
White Eagle Oil

Company

Contractor

COMPLETED

SECTION PLAT

220

_____ Ft. from N. Line

_____ Ft. from S. Line

220

_____ Ft. from E. Line

_____ Ft. from W. Line

ABANDONED

			0

Location _____

Rig up _____

Drilling and Remarks:

RECORD

Cased _____ in., _____ ft.

Sand _____

Gas _____

Oil _____

Total Depth _____

PRODUCTION

1st 24 hrs. Nat. _____

1st 24 hrs. after shot _____

Gas _____ Cu. Ft.

Dry Hole _____

Abandoned _____

Date

JUL 14 1926

192

CHAS. L. SHERWOOD
Scout

old location