


Section 1 Township 22 Range 11-E

Well No. #1 Gardner

Company E. C. Murphy etal

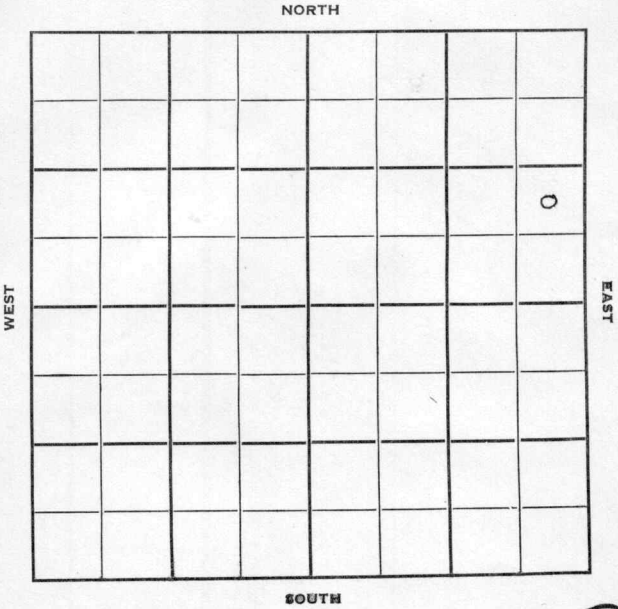

8

Sec. 1 Twp. 22 R. 11-E

Well No. #1 Gardner Farm

E C Murphy etal Company

Contractor


_____ Ft. from N. Line

990 Ft. from S. Line

330 Ft. from E. Line

_____ Ft. from W. Line

NE SE NE

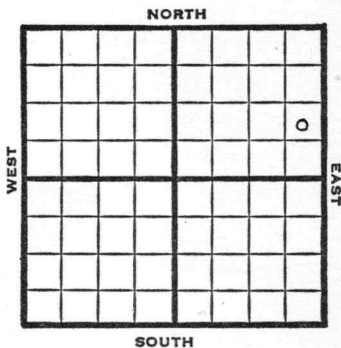

1950

REPORT

9/6

8" @ 42
 5" @ 1848
 TD 1848
 Bart 1860-72
 TD 1876
 25 qt 1860-72
 Comp 12 bopd
 Completed

FIRST REPORT

X

COMPLETED

County Greenwood State Kansas

Sec. 1 (Blk. 22) (Sur. 11E) Map No.

Operator E. C. Murphy etal.

Well No. 1 Farm Gardner

Elev. _____ Location NE SE NE

990 Ft. From S Line NE

330 Ft. From E Line Quarter

1st. Report SEP 6 1950

Completion SEP 6 1950

Remarks _____

Spudding Date _____

Drlg. Data Oil well TD 1876

8" @ 42 5" @ 1848 TD 1848

Bart. 1860-72 TD 1876 25 qt. 1860-72

Comp. 12 bopd

J. E. TYRA