


Map No. _____ Sec. 1 Twp. 22 R. 11 ✓
Well No. 1 Gardner Farm
Howard & Duffield Company

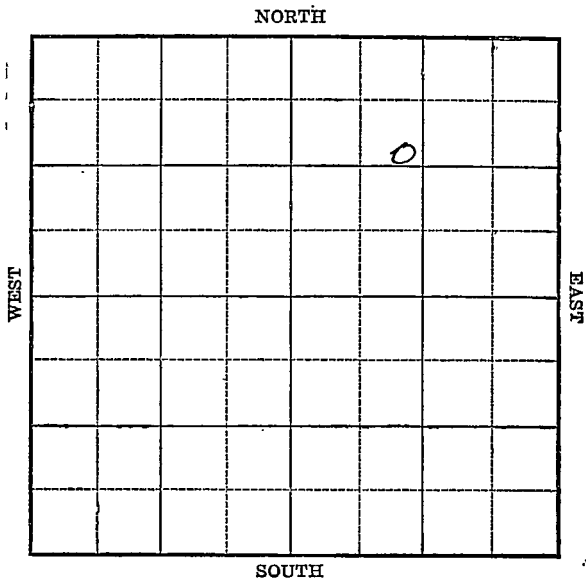

Location _____

Rig up _____

Drilling Remarks:

Drilling Remarks:

RECORD

PRODUCTION

Cased _____ in. _____ ft.

1st 24 hrs Nat. _____

Sand _____

1st 24 hrs. after shot _____

Gas _____

Gas _____ cu. ft.

Oil _____

Dry Hole _____

Total Depth _____

Abandoned _____

Map No. _____ Sec. 1 Twp. 22 R. 11


Well No. 1 Gardner Farm
Howard & Duffield Company

1120 Ft. from N. Line

_____ Ft. from S. Line

_____ Ft. from E. Line

1120 Ft. from W. Line

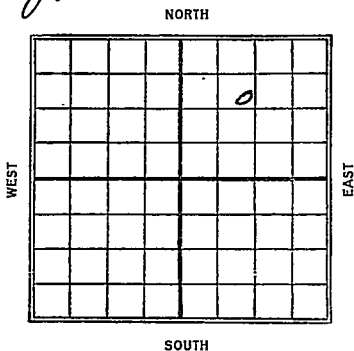

Date
1923
1/12

REPORT

Show 1878 - D. x 9.2/55'

Map No. **KANSAS** 21 Sec. 1 Twp. 22 R. 11

Well No. 1 *Gardner's*

Howard & Knappfield Company

Contractor

ABANDONED

FIRST REPORT

SECTION PLAT

1120 Ft. from N. Line

..... Ft. from S. Line

..... Ft. from E. Line

1120 Ft. from W. Line

Location

Rig up

Drilling and Remarks:

shot 1878
10492156

RECORD

Cased.....in.,ft.

Sand

Gas

Oil

Total Depth.....

PRODUCTION

1st 24 hrs. Nat.....

1st 24 hrs. after shot.....

Gas.....Cu. Ft.

Dry Hole

Abandoned

Date

JAN 12 1923

M. A. BENEAR

191

Scout