


Map No. Kansas Sec. 1 Twp. 22 R. 11
Well No. 1 Vorchees Farm _____
Noble O. & G. Company

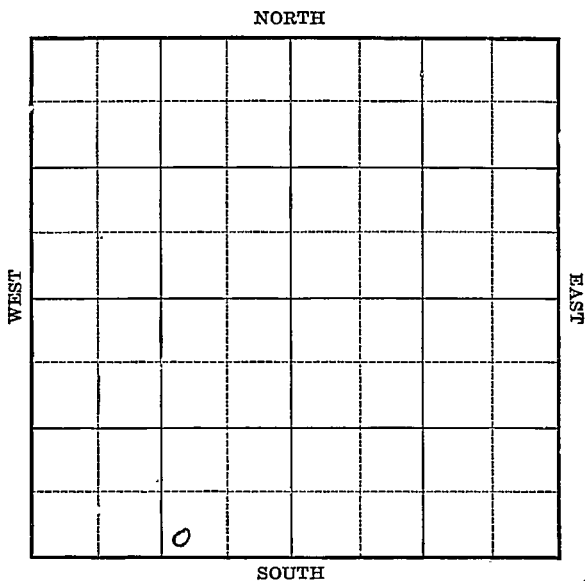

Location _____

Drilling Remarks _____

Rig Up _____

Drilling Remarks _____

RECORD

Cased _____ in. _____ ft.

Sand _____

Gas _____

Oil _____

Total Depth _____

PRODUCTION

1st 24 hrs. Nat. _____

1st. 24 hrs. after shot _____

Gas _____ cu. ft.

Dry Hole _____

Abandoned _____

Map No. Kansas Sec. 1 Twp. 22R 11

Well No. 1 Vorhees Farm


Noble Oil & Gas Company

_____ Ft. from N. Line

330 Ft. from S. Line

990 Ft. from E. Line

_____ Ft. from W. Line

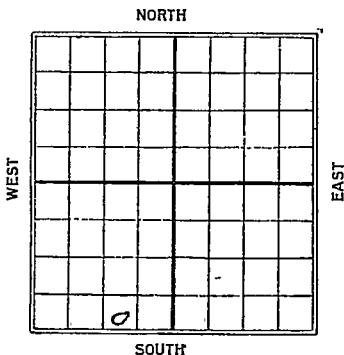

C.

Date 1925 REPORT

6/18 Location

6/26 Spud

7/13 S.D. 600 for water

7/10 10" 922 C.O.

2/17 # 1485

7/24 Top L. 1965' W. lg. 1992'

in line

7/31 Top line 1965'

Qty & kinds LD 2007'

Map No. 11400 Sec. 1 Twp. 22 R. 11

Well No. 1011 Yorkes
Noble Oil & Gas Co Company

Contractor _____

FIRST REPORTS

SECTION PLAT

_____ Ft. from N. Line

330

_____ Ft. from S. Line

990

_____ Ft. from E. Line

_____ Ft. from W. Line

Location _____

Rig up _____

Drilling and Remarks:

RECORD

Cased _____ in., _____ ft.

Sand _____

Gas _____

Oil _____

Total Depth _____

PRODUCTION

1st 24 hrs. Nat. _____

1st 24 hrs. after shot _____

Gas _____ Cu. Ft.

Dry Hole _____

Abandoned _____

Date

JUN 18 1925

CHAS. L. SHERWOOD

Scout

Map No. 2584 Sec. 11 Twp. 22 R. 11

Well No. 111 Vonhes

Noble Oil & Gas Co Company

Contractor

COMPLETED

SECTION PLAT

_____ Ft. from N. Line

330

_____ Ft. from S. Line

990

_____ Ft. from E. Line

_____ Ft. from W. Line

	0		

ABANDONED

Location _____

Rig up _____

Drilling and Remarks:

top line 1965

dry & abandoned

20 700'

RECORD

Cased _____ in., _____ ft.

Sand _____

Gas _____

Oil _____

Total Depth 2007

PRODUCTION

1st 24 hrs. Nat. _____

1st 24 hrs. after shot _____

Gas _____ Cu. Ft.

Dry Hole

Abandoned

Date

JUL 31 1925

CHAS. L. SHERWOOD

192

Scout