


STATE OF KANSAS  
 STATE CORPORATION COMMISSION  
 State Engineer's Office  
 State Conservation Division  
 P. O. Box 17027  
 Wichita, Kansas 67217

WELL PLUGGING RECORD

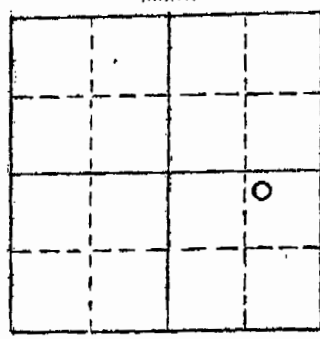

Greenwood County, Sec. 6 Twp. 23N Rge. 10 (E) 1 (W)  
 Location as "NE/CNW/SE/SW" or footage from lines NW NE SE  
 Lease Owner E. T. Lindsay  
 Lease Name Atycos Well No. C-4  
 Office Address Box 1708 Ponca City OKLA 74601  
 Character of Well (completed as Oil, Gas or Dry Hole) OIL  
 Date well completed 11-8-53 1953  
 Application for plugging filed 10/21/74 1974  
 Application for plugging approved 10/22/74 1974  
 Plugging commenced 12-9 1974  
 Plugging completed 12-16 1974  
 Reason for abandonment of well or producing formation Depleted

If a producing well is abandoned, date of last production 1972  
 Was permission obtained from the Conservation Division or its agents before plugging was commenced? Yes

Name of Conservation Agent who supervised plugging of this well Merle Hickey  
 Producing formation Bartlesville & MISS Depth to top 2227 Bottom 2322 Total Depth of Well 2357 Feet  
 Show depth and thickness of all water, oil and gas formations.

OIL, GAS OR WATER RECORDS				CASING RECORD		
FORMATION	CONTENT	FROM	TO	SIZE	PUT IN	PULLED OUT
<u>Bartlesville</u>	<u>OIL</u>	<u>2227</u>	<u>2314</u>	<u>10 3/4"</u>	<u>63'</u>	<u>None</u>
<u>MISSISSIPPI</u>	<u>OIL</u>	<u>2314</u>	<u>-</u>	<u>7 1/4"</u>	<u>2387'</u>	<u>1060'</u>

Describe in detail the manner in which the well was plugged, indicating where the mud fluid was placed and the method or methods used in introducing it into the hole. If cement or other plugs were used, state the character of same and depth placed, from \_\_\_\_\_ feet to \_\_\_\_\_ feet for each plug set.

- 12-9-74 Dumped 5 sacks cement on bottom.
- 12-10-74 Ripping on pipe.
- 12-11-74 Ripping on pipe. Pulled 4 joints out.
- 12-12-74 Pulled 7" pipe. Set bridge at 200', put in 12 sacks cement. Set bridge at 30', put in 8 sacks cement.

RECEIVED  
 STATE CORPORATION COMMISSION  
 JAN 27 1975  
 CONSERVATION DIVISION  
 Wichita, Kansas

Name of Plugging Contractor White & Ellis Drilling, Inc.  
 Address Box 448, El Dorado, Kansas 67042

STATE OF Kansas COUNTY OF Butler SS.  
Ernest Sifford (employee of owner) or (owner or operator) of the above-described well, being first duly sworn on oath, says: That I have knowledge of the facts, statements, and matters herein contained and the log of the above-described well as filed and that the same are true and correct. So help me God.



(Signature) Ernest Sifford  
 (Address) \_\_\_\_\_

Subscribed and sworn to before me this 17th day of December 1974  
L. B. Auer  
 L. B. Auer Notary Public.  
 September 26, 1974