


Section 10 Township 22 Range 2 E

Well No. # 1 Ullum

Company Westgate-Greenland

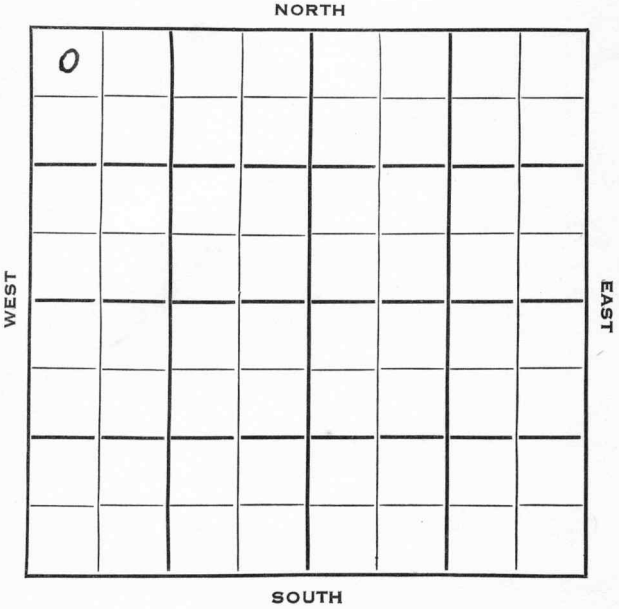

Harvey

KANSAS


 Sec. 10 Twp. 22 R. 2E

 Well No. #1 Ullum Farm

Westgate-Greenland Company

W-G Contractor


Wildcat
330 Ft. from N. Line

_____ Ft. from S. Line

_____ Ft. from E. Line

330 Ft. from W. Line

NW NW NW

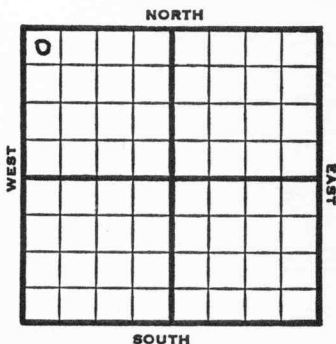

1953

Elev. 1454'

REPORT

5/13

Spud 5-9-53

8" @ 112

Drlg. 620'

5/27

Spud 5-9-53

D&A

TD 3304

8" @ 112

Heeb 1859, Lans 2139, B KC 2546,

Burgess 2757, Miss 2806, Hunton

3105, Maq. 3151, Viola 3163, Simp

3241, Arb 3262


TD 3304

D&A

ABANDONED

County **Harvey** State **Kansas**
 Sec. **10** (Blk.) **22** (Sur.) **2E** Map No.
 (Twp.)
 Operator **Westgate-Greenland**
 Well No. **1** Farm **Ullum**

Elev. Location **NW NW NW**

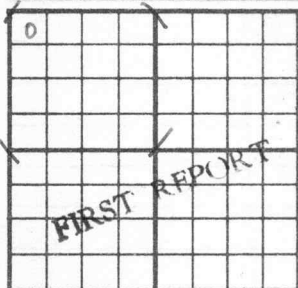

330 Ft. From **N** Line **NW**

330 Ft. From **W** Line Quarter

1st. Report **MAY 13 1953**

Completion

Remarks

W-G - Contr.

Spudding Date **5-9-53**

Drlg. Data

Wildcat

8" @ 112 drlg. 620

J. G. McGEHEE

County Harvey State Kansas
 Sec. 10 (Blk.) 22 (Sur. Rge.) 2E Map No. _____
 Operator Westgate-Greenland
 Well No. 1 Farm Ullum
 Elev. 1454 Location NW NW NW



330 Ft. From N Line NW
330 Ft. From W Line Quarter

1st. Report _____

Completion MAY 27 1953

Remarks Wildcat
W-G - Contr.

Spudding Date 5-9-53

Drlg. Data D & A TD 3304

8" @ 112 Heeb. 1859 Lans. 2139

B KC 2546 Burgess 2757 Miss. 2806

Hunton 3105 Maq. 3151 Viola 3163

Simp. 3241 Arb. 3262 TD 3304

D & A

J. G. McGEHEE