


Marion

KANSAS

SECTION 10 TOWNSHIP 22 RANGE 4E

WELL NO. #1 Brooks "B"

COMPANY Red Drlg. Co.

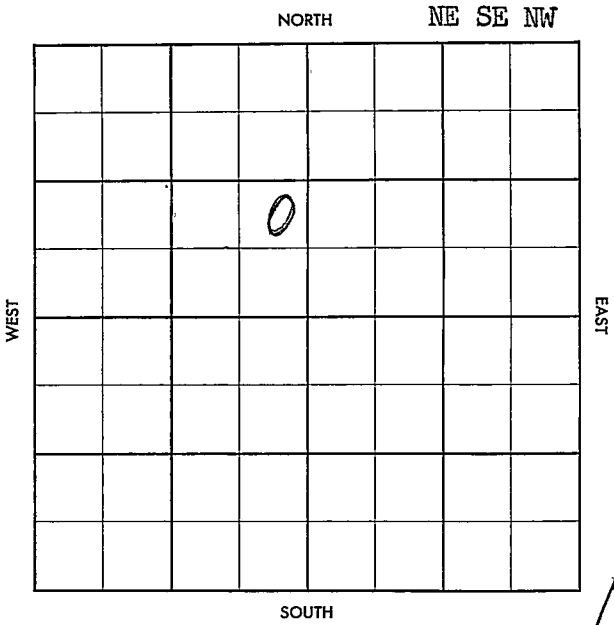

County Mason Elev. 1426 DF
 Sec. 10 Twp. 22 Rge. 1/E
 Company Red Drlg. Co.
 Farm Name Brooks "B" No. 1

TOPS	DEPTH	LOG	DATUM	Loc. in Sec.																																
Anh.				NE SE NW																																
Tp.																																				
H.																																				
Tr.																																				
Dg.																																				
Bl.																																				
L.	1811			Geol.																																
K.C.	1978			Contr.																																
B.K.C.	2173			Co. Tools																																
Ce.				Pool																																
C.				Peabody																																
M. <u>Ians.</u>	2287			<table border="1"> <tr><td></td><td></td><td></td><td></td></tr> <tr><td></td><td></td><td></td><td></td></tr> <tr><td></td><td></td><td></td><td></td></tr> <tr><td></td><td></td><td></td><td></td></tr> <tr><td></td><td></td><td></td><td></td></tr> <tr><td></td><td></td><td></td><td></td></tr> <tr><td></td><td></td><td></td><td></td></tr> <tr><td></td><td></td><td></td><td></td></tr> </table>																																
M. <u>chat</u>	2314																																			
K.																																				
Mz.																																				
Mq.																																				
V.																																				
S.	2492																																			
S.																																				
A.	2493																																			
R.																																				
Pe.																																				
G.																																				
T.D.																																				

Date Comm. 8-27-57
8" @ 200, DST 2048-70 op 1 hr. failed, 5" @
2493, RFD 2495, WOC

Handwritten signature/initials

FIRST REPORT
 SEP 4 57

Co.
Lse.
No.
Sec.
T.
R.

CORRECTION

FORM 513 SUNRAY

County Marion Elev. 1426 DF
 Sec. 10 Twp. 22 Rge. 11E
 Company Red Drlg. Co. Geo SIGGIST
 Farm Name Brooks No. 1

TOPS	DEPTH	LOG	DATUM	Loc. in Sec.						
Anh.				NE SE NW						
TP.										
H.										
Tr.										
Dg.				Geol.						
BL										
L.	1811									
K.C.	1978			Contr.						
B.K.C.	2173									
Ce.				Co. Tools						
C.										
M. <u>lans.</u>	2287									
M. <u>chat</u>	2311			Pool						
K.	2386									
Mz.				Peabody						
Mo.										
V.				<table border="1" style="width: 100%; height: 100%;"> <tr> <td style="text-align: center;">NOV</td> <td style="text-align: center;">6</td> <td style="text-align: center;">57</td> </tr> <tr> <td style="text-align: center;">0</td> <td></td> <td></td> </tr> </table>	NOV	6	57	0		
NOV	6	57								
0										
S.	2492									
S. <u>How</u>										
TD <u>HUWT</u>	2493									
R.				COMPLETE						
PE.										
G.										
TD.	2495									

Date Comm. 8-27-57

8" @ 200, DST 2048-70 op 1 hr. failed. 5" @
2493, RTD 2495, NOC SEP 1 57 CO 2495
SEP 18 57 on p SEP 25 57 2 3" FU
600' Eld NBD P 9090 W
OCT 1 57 " " " "
NOV 6 57 BP 2400 124/2307-40 750 MA
5 BO 24 hrs P 25 BO NW
24 hrs

Co. Lse. No. Sec. T. R.