


Map No. _____ Sec. 10 Twp. 22 R. 4

Well No. 3 Brooks Farm
Orlando Pet. Company

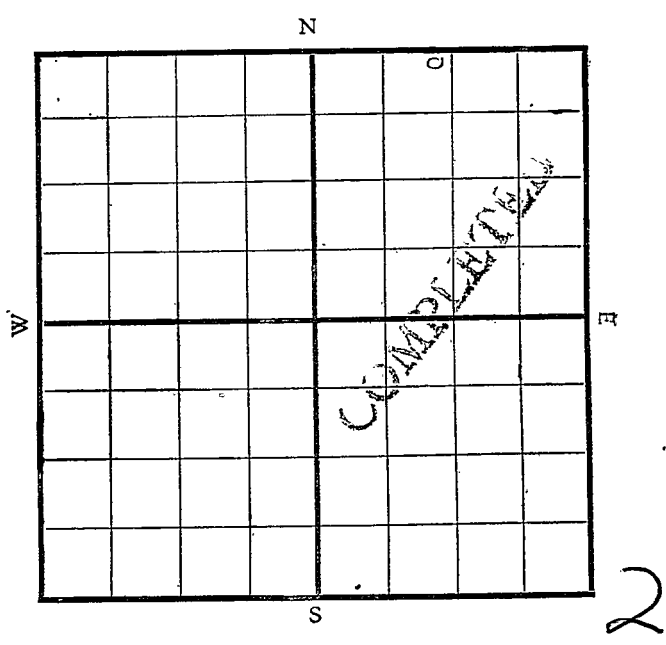

Location _____

Drilling Remarks:

RECORD

Cased _____ in. _____ ft.

Sand _____

Gas _____

Oil _____

Total Depth _____

Rig Up _____

Drilling Remarks:

PRODUCTION

1st 24 hrs. Nat. _____

1st 24 hrs. after shot _____

Gas _____ cu. ft.


Dry Hole _____

Abandoned _____

Map No. _____ Sec. 10 Twp. 32 R. 4

Well No. 3 Brooks Farm
Orlando Pet. Company

150 Ft. from N. Line
 _____ Ft. from S. Line
 _____ Ft. from E. Line
1120 Ft. from W. Line

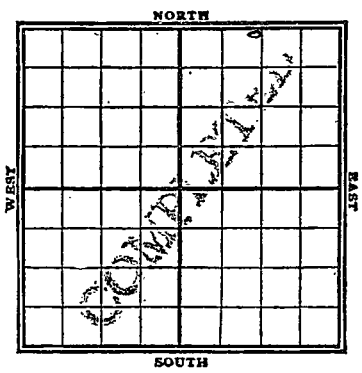

Date	REPORT
1920	
1/19	Rig up
26	Rig
2/2	✓
9	Rig up
16	Rig
21	Tools
27	15 1/2" - 200'
8	Relg 250
15	✓ 700
22	✓ 1000'
29	SD 1000'
4/12	1245
24	1625
30	1800
5/3	2075
10	2260
22	6 5/8" - 2310
25	relg. @ 2350'
31	W.P. 8" to 2502'
6/7	for holes 2505'
22	Dry 2532

6/15. egg tunnel @ 2505

Map No. K23 Sec. 10 Twp. 22 R. 4

Well No. 2 Brooks

Orlando Pet Company

Contractor

SECTION PLAT

150 Ft. from N. Line

----- Ft. from S. Line

----- Ft. from E. Line

1120 Ft. from W. Line

		o	

FIRST REPORT

CHANGE LESSEE NAME

Location

Rig up

Drilling and Remarks:

RECORD

Cased ----- in., ----- ft.

Sand -----

Gas -----

Oil -----

Total Depth -----

PRODUCTION

1st 24 hrs. Nat. -----

1st 24 hrs. after shot -----

Gas ----- Cu. Ft.

Dry Hole -----

Abandoned -----

Date

Pyle

1/19 1920

Scout

MAP No. _____ SEC. 10 TWP. 22S R. 1E

WELL No. 3 Brooks
8 Empurst COMPANY

CONTRACTOR

SECTION PLAT

			①

_____ FT. FROM N. LINE

_____ FT. FROM S. LINE

_____ FT. FROM E. LINE

_____ FT. FROM W. LINE

OK

LOCATION _____

RIG UP _____

DRILLING AND REMARKS:

RECORD

CASED _____ IN. _____ FT.

SAND _____

GAS _____

OIL _____

TOTAL DEPTH 287

PRODUCTION

1ST 24 HRS. NAT. _____

1ST 24 HRS. AFTER SHOT _____

GAS _____ CU. FT.

DRY HOLE

ABANDONED _____

DATE

4/21 1920

SCOUT

Map No. K 23 Sec. 10 Twp. 22 R. 4

Well No. 3 Brooks
Orlando Pet Company

Contractor

SECTION PLAT

150 Ft. from N. Line

_____ Ft. from S. Line

_____ Ft. from E. Line

1120 Ft. from W. Line

		o	

Location _____

Rig up

Drilling and Remarks:

Change number

RECORD

Cased _____ in., _____ ft.

Sand _____

Gas _____

Oil _____

Total Depth _____

PRODUCTION

1st 24 hrs. Nat. _____

1st 24 hrs. after shot _____

Gas _____ Cu. Ft.

Dry Hole _____

Abandoned _____

Date

7/9 1920

Pyle

Scout

Map No. 123 Sec. 10 Twp. 22 R. 4

Well No. 3 Brooks
Orlando Pet Company

Contractor

SECTION PLAT

150 Ft. from N. Line

----- Ft. from S. Line

----- Ft. from E. Line

1120 Ft. from W. Line

		⊙	1

COMPLETED

Location -----

Rig up -----

Drilling and Remarks:

RECORD

Cased ----- in., ----- ft.

Sand -----

Gas -----

Oil -----

Total Depth -----

PRODUCTION

1st 24 hrs. Nat. -----

1st 24 hrs. after shot -----

Gas ----- ¹/₁ Cu. Ft.

Dry Hole 2532 -----

Abandoned -----

Date 6/22 1920

Pyle Scout