


Map No. \_\_\_\_\_ Sec. 10 Twp. 22 R. 4  
Well No. 4 Brooks Farm \_\_\_\_\_  
Orlando Pet. Company \_\_\_\_\_

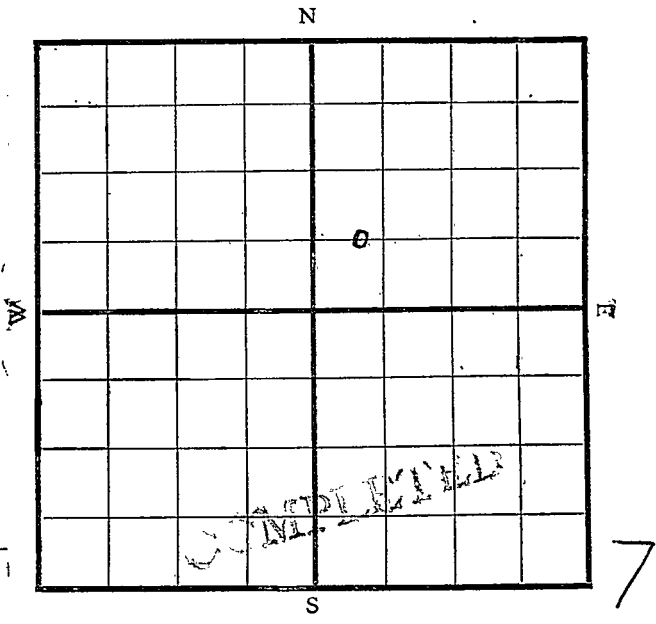

Location \_\_\_\_\_

Drilling Remarks:

\_\_\_\_\_

\_\_\_\_\_

Rig Up \_\_\_\_\_

Drilling Remarks:

\_\_\_\_\_

\_\_\_\_\_

**RECORD**

Cased \_\_\_\_\_ in. \_\_\_\_\_ ft.

Sand \_\_\_\_\_

Gas \_\_\_\_\_

Oil \_\_\_\_\_

Total Depth \_\_\_\_\_

**PRODUCTION**

1st 24 hrs. Nat. \_\_\_\_\_

1st 24 hrs. after shot \_\_\_\_\_

Gas \_\_\_\_\_ cu. ft.

Dry Hole \_\_\_\_\_

Abandoned \_\_\_\_\_

Map No. K Sec. 10 Twp. 22 R. 4


Well No. 4 Brooks Farm  
Orlando Pet Company

\_\_\_\_\_ Ft. from N. Line

660 Ft. from S. Line

\_\_\_\_\_ Ft. from E. Line

200 Ft. from W. Line

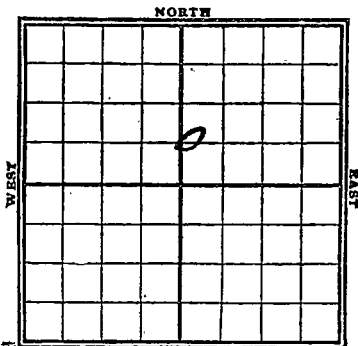

COMPLETION

Date

REPORT

WASI REPORT

6/5	Rig up.
22	Stand
28	400
7/7	920
12	1550
19	1860
26	8" @ 2750'
8/2	6 1/2 @ 2000'
8/9	2.20 @ 2500'
8/16	2500 - 02 - 40. bbls oil 200 bbls water

Map No. K 23 Sec. 10 Twp. 22 R. 4

Well No. 4 Brooks

Orlando Pet Company

Contractor

SECTION PLAT

\_\_\_\_\_ Ft. from N. Line

660 Ft. from S. Line

\_\_\_\_\_ Ft. from E. Line

200 Ft. from W. Line

		⊙	

**FIRST REPORT**

Location \_\_\_\_\_

Rig up

Drilling and Remarks:

RECORD

Cased \_\_\_\_\_ in., \_\_\_\_\_ ft.

Sand \_\_\_\_\_

Gas \_\_\_\_\_

Oil \_\_\_\_\_

Total Depth \_\_\_\_\_

PRODUCTION

1st 24 hrs. Nat. \_\_\_\_\_

1st 24 hrs. after shot \_\_\_\_\_

Gas \_\_\_\_\_ Cu. Ft.

Dry Hole \_\_\_\_\_

Abandoned \_\_\_\_\_

Date

6/15 1920

Pyle Scout

Map No. K23 Sec. 10 Twp. 22 R. 4

Well No. 4 Brooks  
Orlando Gas Company

Contractor

SECTION PLAT

\_\_\_\_\_ Ft. from N. Line

660 Ft. from S. Line

\_\_\_\_\_ Ft. from E. Line

200 Ft. from W. Line

		6	
<b>COMPLETED</b>			

Location \_\_\_\_\_

Rig up \_\_\_\_\_

Drilling and Remarks:

40 bbls Oil  
300 bbls water

RECORD

Cased \_\_\_\_\_ in., \_\_\_\_\_ ft.

Sand 2500 - 2502

Gas \_\_\_\_\_

Oil \_\_\_\_\_

Total Depth \_\_\_\_\_

PRODUCTION

1st 24 hrs. Nat. \_\_\_\_\_

1st 24 hrs. after shot \_\_\_\_\_

Gas \_\_\_\_\_ Cu. Ft.

Dry Hole \_\_\_\_\_

Abandoned \_\_\_\_\_

Date

8/16 19120

**Pyle**

Scout