


Map No. T 22 Sec. 10 Twp. 22 R. 4

Well No. 5 Brooks Farm  
Arlandu Put Company

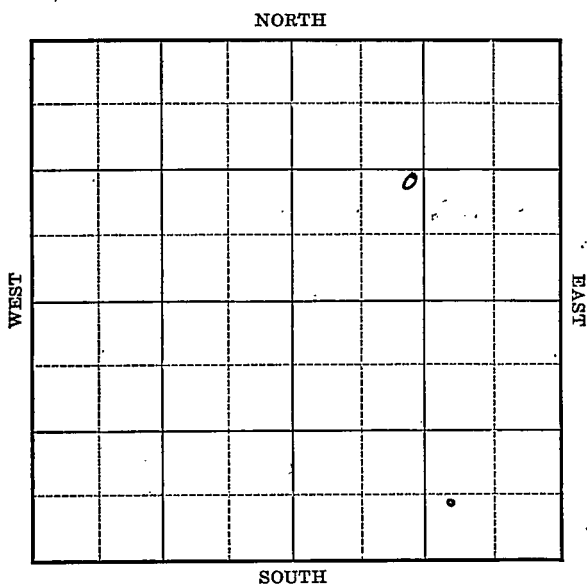

**COMPLETED**

Location \_\_\_\_\_

Rig Up \_\_\_\_\_

Drilling Remarks:

Drilling Remarks:

-----

-----

RECORD

PRODUCTION

Cased \_\_\_\_\_ in. \_\_\_\_\_ ft.

Sand \_\_\_\_\_

Gas \_\_\_\_\_

Oil \_\_\_\_\_

Total Depth \_\_\_\_\_

1st 24 hrs. Nat. \_\_\_\_\_

1st 24 hrs. after shot \_\_\_\_\_

Gas \_\_\_\_\_ cu. ft.

Dry Hole \_\_\_\_\_

Abandoned \_\_\_\_\_

Map No. N. 23 Sec. 10 Twp. 22 R. 4


Well No. 5 Brooks Farm  
Orlando Pet. Company

\_\_\_\_\_ Ft. from N. Line

1120 Ft. from S. Line

\_\_\_\_\_ Ft. from E. Line

1120 Ft. from W. Line

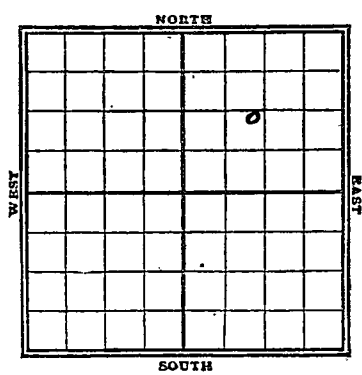

Date 1940

REPORT  
**FIRST REPORT**

<u>8/23</u>	<u>Aug up</u>
<u>8/31</u>	<u>L</u>
<u>9/13</u>	<u>dry 500</u>
<u>90</u>	<u>2 800'</u>
<u>27</u>	<u>1575'</u>
<u>10/28</u>	<u>dry hole 2534'</u>

Map No. K 23 Sec. 10 Twp. 22 R. 4

Well No. 5 Brooks  
Orlando Pet Company

Contractor

SECTION PLAT

		⊙	

**FIRST REPORT**

----- Ft. from N. Line

1120 Ft. from S. Line

----- Ft. from E. Line

1120 Ft. from W. Line

Location -----

Rig up  -----

Drilling and Remarks:

RECORD

Cased ----- in., ----- ft.

Sand -----

Gas -----

Oil -----

Total Depth -----

PRODUCTION

1st 24 hrs. Nat. -----

1st 24 hrs. after shot -----

Gas ----- Cu. Ft.

Dry Hole -----

Abandoned -----

Date

8/23 1910

**Pyle**

Scout

Map No. K 23 Sec. 10 Twp. 22 R. 4

Well No. 5 Brooks  
Orlando Jet Company

Contractor \_\_\_\_\_

SECTION PLAT

\_\_\_\_\_ Ft. from N. Line

1120 Ft. from S. Line

\_\_\_\_\_ Ft. from E. Line

1120 Ft. from W. Line

		Ø	
<b>COMPLETED</b>			

Location \_\_\_\_\_

Rig up \_\_\_\_\_

Drilling and Remarks:

RECORD

Cased \_\_\_\_\_ in., \_\_\_\_\_ ft.

Sand \_\_\_\_\_

Gas \_\_\_\_\_

Oil \_\_\_\_\_

Total Depth \_\_\_\_\_

PRODUCTION

1st 24 hrs. Nat. \_\_\_\_\_

1st 24 hrs. after shot \_\_\_\_\_

Gas \_\_\_\_\_ Cu. Ft.

Dry Hole 2534

Abandoned \_\_\_\_\_

Date

10/28 1920

**Pyle** Scout

MAP NO. \_\_\_\_\_ SEC. 10 TWP. 27S R. 1E

WELL NO. 5 Brooks  
3 Embury COMPANY

CONTRACTOR

SECTION PLAT

		0	

\_\_\_\_\_ FT. FROM N. LINE

\_\_\_\_\_ FT. FROM S. LINE

\_\_\_\_\_ FT. FROM E. LINE

\_\_\_\_\_ FT. FROM W. LINE

*OK*

LOCATION \_\_\_\_\_

RIG UP \_\_\_\_\_

DRILLING AND REMARKS:

RECORD

CASED \_\_\_\_\_ IN. \_\_\_\_\_ FT.

SAND \_\_\_\_\_

GAS \_\_\_\_\_

OIL \_\_\_\_\_

TOTAL DEPTH 2534

PRODUCTION

1ST 24 HRS. NAT. \_\_\_\_\_

1ST 24 HRS. AFTER SHOT \_\_\_\_\_

GAS \_\_\_\_\_ CU. FT.

DRY HOLE

ABANDONED

DATE Dec 25 1920

SCOUT