


Greenwood

Form 51-5M-2-29-34703

Map No. **KANSAS** Sec. *10* Twp. *22* R. *10* ✓

Well No. *1-Phillips* *Pidley* Farm
Phillips *Per* Company

NORTH

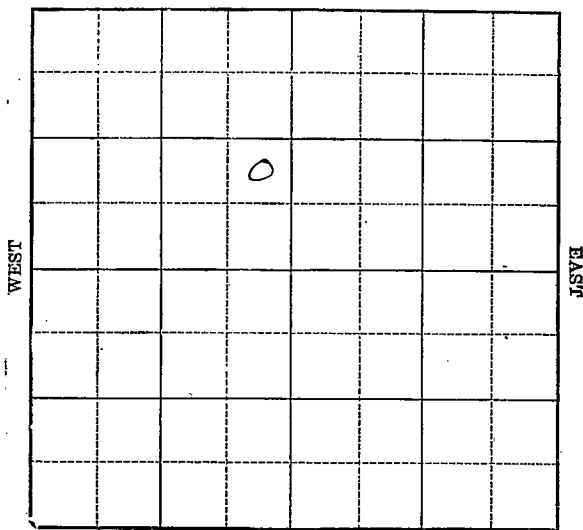

SOUTH

Location

Drilling Remarks

Rig Up

Drilling Remarks

RECORD

Cased _____ in. _____ ft.

Sand _____

Gas _____

Oil _____

Total Depth _____

PRODUCTION

1st 24 hrs. Nat. _____

1st 24 hrs. after shot _____

Gas _____ cu. ft.

Dry Hole _____

Abandoned _____

Greenwood
FORM 252A-5M-12-28-PETROL


Well No. 1- Bidlee Farm

Phillips Petroleum Company

990 Ft. from S. Line

Ft. from W. Line

1929

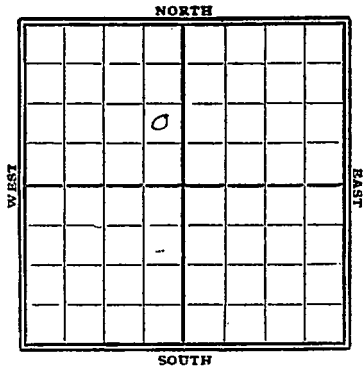

REPORT

3/20	Bldy Rg
3/27	Spdy.
4/3	Only 750'
4/10	" 1310'
4/17	" 2100'
4/24	Top sand 2255-75-T.D. shot 90 gts 440. lbs 24-hrs Pomp.

Sherwood

21 KANSAS Sec. 10 Twp. 22 R. 10

Well No. *1* *Phillips* *pet* Co. Company

Contractor

FIRST REPORTS

.....Ft. from N. Line

990 Ft. from S. Line

330 Ft. from E. Line

.....Ft. from W. Line

SECTION PLAT

1			
	0		

Location: *Blag Rig*

Rig up

Drilling and Remarks:

RECORD

Cased.....in.,ft.

Sand.....

Gas.....

Oil.....

Total Depth.....

PRODUCTION

1st 24 hrs. Nat.....

1st 24 hrs. after shot.....

Gas.....Cu. Ft.

Dry Hole.....

Abandoned.....

Date

MAR 20 1929

CHAS. L. SHERWOOD

Scout

S. Sherwood

Map No. **KANSAS** Sec. **10** Twp. **22** R. **10**Well No. **21** **1** **Fix Lee****Phillips Petr Co** Company

Contractor

COMPLETE

SECTION PLAT

	o		

Ft. from N. Line

990 Ft. from S. Line**330** Ft. from E. Line

Ft. from W. Line

Location

Rig up

Drilling and Remarks:

90/440 Bls.

RECORD

Cased in, ft.

Sand **2255-2275**

Gas

Oil

Total Depth **2275**

PRODUCTION

1st 24 hrs. Nat.

1st 24 hrs. after shot

Gas Cu. Ft.

Dry Hole

Abandoned

Date

APR 24 1929

192

CHAS. L. SHERWOOD

Scout