

Map No. KANSAS Sec. 10 Twp. 22 R. 10


Well No. 4 - Ripley Farm
Trans-Continental Company

990 Ft. from N. Line

_____ Ft. from S. Line

_____ Ft. from E. Line

330 Ft. from W. Line

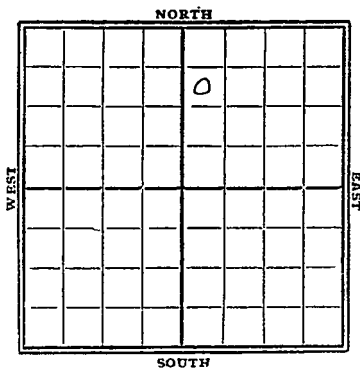

1929

Date

REPORT

Date	REPORT
4/24	Location
5/11	Timbers
5/18	Drly 350'
5/15	" 860'
5/22	" 1610'
5/29	sand 2249-70' swab 500 bbls 24 hr. kill shot
6/5	P.B. to 2266' shot 40 gts and swab 250 bbl 4 hrs.
6/12	sand 2249-70' T.D. 2270' P.B. to 2266' shot 40 gts 700 bbls oil Sump

Greenwood

Map No. **KANSAS** Sec. *10* Twp. *22* R. *10*

Well No. *21* *4 Pixley*

Transcontinental Oil Co. Company

Contractor


SECTION PLAT

990 Ft. from N. Line

..... Ft. from S. Line

..... Ft. from E. Line

330 Ft. from W. Line

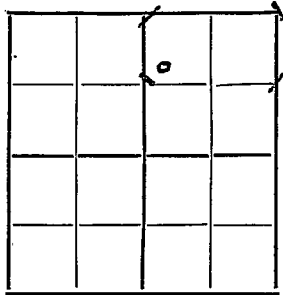

FIRST REPORTS

Location

Rig up.....

Drilling and Remarks:

RECORD

Cased.....in.,ft.

Sand.....

Gas.....

Oil.....

Total Depth.....

PRODUCTION

1st 24 hrs. Nat.....

1st 24 hrs. after shot.....

Gas..... Cu. Ft.

Dry Hole.....

Abandoned.....

Date
APR 24 1929

CHAS. L. SHERWOOD
192..... Scout

Greenwood

21 **KANSAS** Sec. 10 Twp. 22 R. 10

Well No. 4 *Pixley*

Transcontinental Oil Company

Contractor

COMPLETE

SECTION PLAT

990 Ft. from N. Line

Ft. from S. Line

Ft. from E. Line

330 Ft. from W. Line

		0	

Location

Rig up

Drilling and Remarks:

AB to 2266

40/700 Bls

RECORD

Cased in., ft.

Sand *2249-2270*

Gas

Oil

Total Depth *2270*

PRODUCTION

1st 24 hrs. Nat.

1st 24 hrs. after shot

Gas Cu. Ft.

Dry Hole

*Abandoned

Date

JUN 12 1929

192

CHAS. L. SHERWOOD

Scout