

Section 10 Township 22 Range 12E

Well No. 1<sup>B</sup> oles

Company Ale Oil

NORTH


15

WEST

EAST

0

SOUTH

Greenwood **KANSAS**


SEC.	TWP.	R.
10	22	12E

WELL NO. **1 Boles** FARM

COMPANY **Ale Oil**

CONTRACTOR **Sauder**

\_\_\_\_\_ Ft. from N. Line  
**330** \_\_\_\_\_ Ft. from S. Line  
 \_\_\_\_\_ Ft. from E. Line  
**330** \_\_\_\_\_ Ft. from W. Line

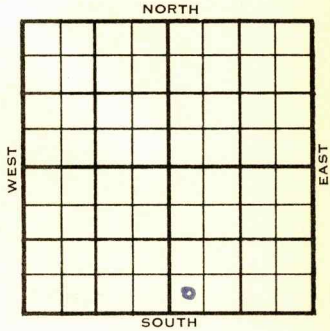

SW SW SE

ELEVATION	REPORT
-----------	--------

1955

3/9 Drlg. 400'  
 Spud 3-6-55  
 3/23 Spud 3-6-55, 10" @ 763,  
**Bart 1704, Miss 1799,**  
 TD 1864  
 D&A

**ABANDONED**



