


SECTION 10 TOWNSHIP _____ RANGE 22 12E

WELL NO. #1 Boles

COMPANY W.E. Ellis

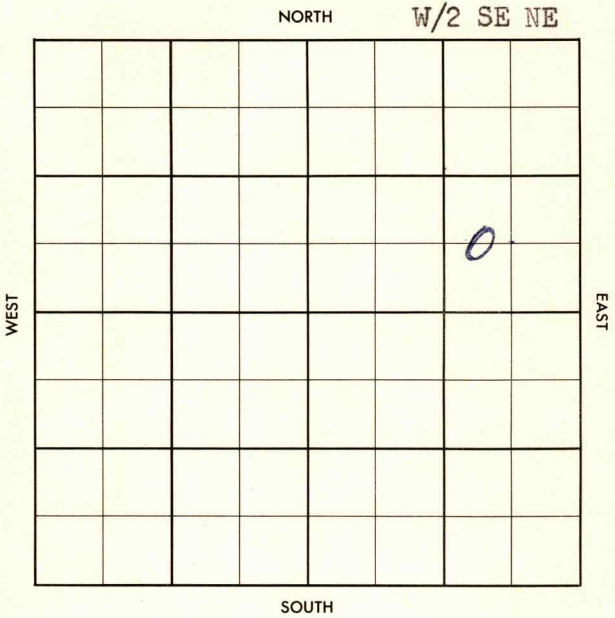

County Greenwood Elev. _____
 Sec. 10 Twp. 22 Rgs. 12E
 Company W. E. Ellis
 Farm Name Boles No. 1

TOPS	DEPTH	LOG	DATUM
Anh.			
Tp.			
H.			
Tr.			
Dg.			
Bl.			
L.			
K.C.			
B.K.C.			
Ce.			
C.			
M.			
M.			
K.			
Mz.			
Me.			
V.			
S.			
S.	<u>Btvl sd</u>	<u>1737</u>	
A.			
R.			
Pe.			
G.			
T.D.		<u>1746</u>	


Loc. in Sec. W/2 SE NE

Geol. _____
 Contr. Berentz Tools

Pool Frankhouser

FIRST REPORT	
	o
JUN 26 '57	

Date Comm. 6-17-57
5" @ 1738

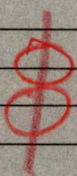

Co.
 Lsg.
 No.
 Sec.
 T.
 R.

Co.

County Greenwood Elev. _____
 Sec. 10 Temp. 22 Rge. 12E
 Company W. E. Ellis
 Farm Name Boles No. 1

TOPS	DEPTH	LOG	DATUM	Loc. in Sec.
Anh.				W/2 SE NE
Tp.				
H.				
Tr.				
Dg.				
Bl.				
L.				Geol. _____
K.C.				Contr. _____
B.K.C.				Berentz Tool
Ce.				
C.				Pool
M.				
M.				Frankhouser
K.				
Mz.				
Ma.				
V.				
S.				<div style="border: 1px solid black; padding: 5px; text-align: center;"> COMPLETE JUL 17 1957 </div>
S. Btvl sd	1737			
A.				
R.				
Pf.				
G.				
T.D.		1746		

U.S.G.

No.

Sec.

T.

R.

Date Comm. 6-17-57
5" @ 1738 JUL 17 1957 CO 1756 DD
1756 Post P. 10 Bopd
no wts, + 30 Bwpd.