


Greenwood

Map No. *15* Sec. *10* Twp. *22* R. *12*

Well No. *1 - Boles* Farm
Darby & Belliere Company

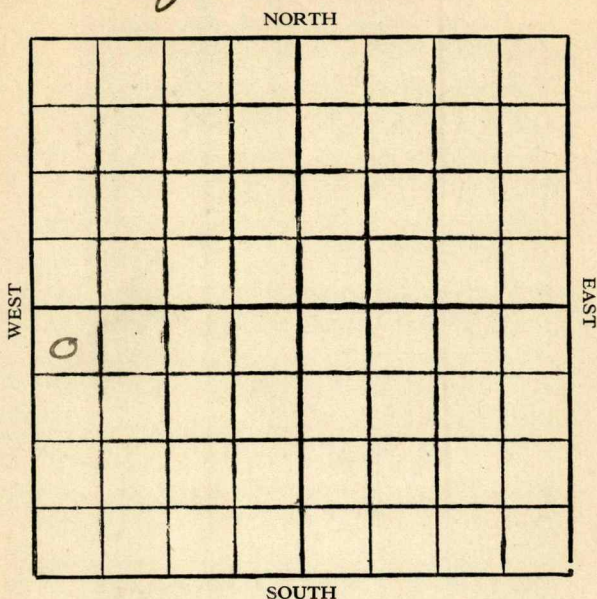

Location

Drilling Remarks

Rig Up.....

Drilling Remarks

RECORD

Cased in. ft.

Sand

Gas

Oil

Total Depth

PRODUCTION

1st 24 hrs. Nat.

1st 24 hrs. after shot

Gas cu. ft.


Dry Hole

Abandoned

*Greenwood*Map No. *KS* Sec. *10* Twp. *22* R. *12*Well No. *1 - Boles* Farm*Sarby & Belliere* Company*330* Ft. from N. Line

_____ Ft. from S. Line

_____ Ft. from E. Line

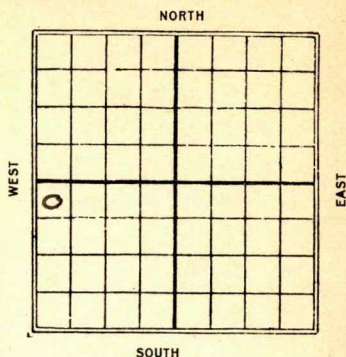330 Ft. from W. Line*1927*

Date

REPORT

Date	REPORT
<i>1/6</i>	<i>R.O.G.</i>
<i>1/13</i>	<i>Rigging up</i>
<i>1/19</i>	<i>spudding 300</i>
<i>1/26</i>	<i>Drilling 900</i>
<i>2/3</i>	<i>" 1650</i>
<i>2/10</i>	<i>sand 1790-1821</i>
	<i>80/100 bbls</i>
	<i>I.D. 1824'</i>

Sherwood
 21 **KANSAS** 10 22 12
 Map No. Sec. Twp. R.
 Well No. 1 Boles
Virley & Bellamy Company

Contractor


COMPLETED**SECTION PLAT**

330 Ft. from N. Line

Ft. from S. Line

Ft. from E. Line

330 Ft. from W. Line

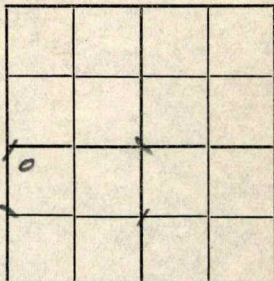

Location

Rig up

Drilling and Remarks:

80/100 Bl.

RECORD

Cased in. ft.

Sand 1790-1821

Gas

Oil

Total Depth 1824

PRODUCTION

1st 24 hrs. Nat.

1st 24 hrs. after shot

Gas Cu. Ft.

Dry Hole

Abandoned

Date

FEB 10 1927

192

CHAS. L. SHERWOOD

Scout

Sherwood

21 KANSAS Map No. Sec. 10 Twp. 22 R. 12

Well No. 1 Boles

Darby & Bellaire Company

Contractor

FIRST REPORTS

SECTION PLAT

330 Ft. from N. Line

Ft. from S. Line

Ft. from E. Line

330 Ft. from W. Line

X		X	
X		X	

Location

Rig up

Drilling and Remarks:

R 0 8

RECORD

Cased _____ in., _____ ft.

Sand _____

Gas _____

Oil _____

Total Depth _____

PRODUCTION

1st 24 hrs. Nat. _____

1st 24 hrs. after shot _____

Gas _____ Cu. Ft.

Dry Hole _____

Abandoned _____

Date

JAN 6 1927

CHAS. L. SHERWOOD

192 Scout