

Section 10 Township 22 Range 12E

Well No. #1 Swanson "B"

Company Glenwood Oil

NORTH

0							

WEST

EAST

SOUTH

4

Sec. 10 Twp. 22 R. 12 E

Well No. # 1 Swanson "B" Farm

Glenwood Oil Company

Contractor


990 Ft. from N. Line

_____ Ft. from S. Line

_____ Ft. from E. Line

330 Ft. from W. Line

100' NE of SW NW NW
(Twin well)

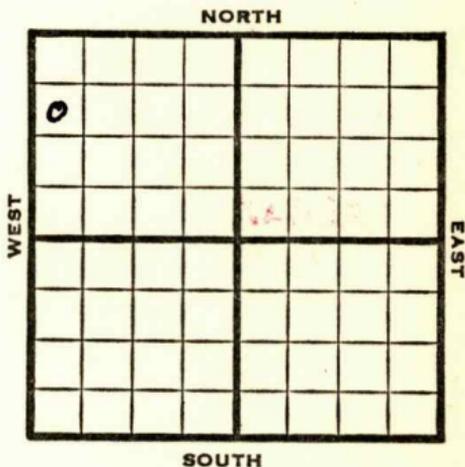

REPORT

1951

2/14

RUR

3/14

Oil well TD 1835'
7" @ 80 **Bart. 1800'** 4" @ 1800'
TD 1835'
Comp. 5 BOPD

FIRST REPORT
COMPLETED

