


KANSAS

Greenwood

Section 10 Township 22 Range 12E ✓

Well No. #2 Swanson "B"

Company Glenwood Oil

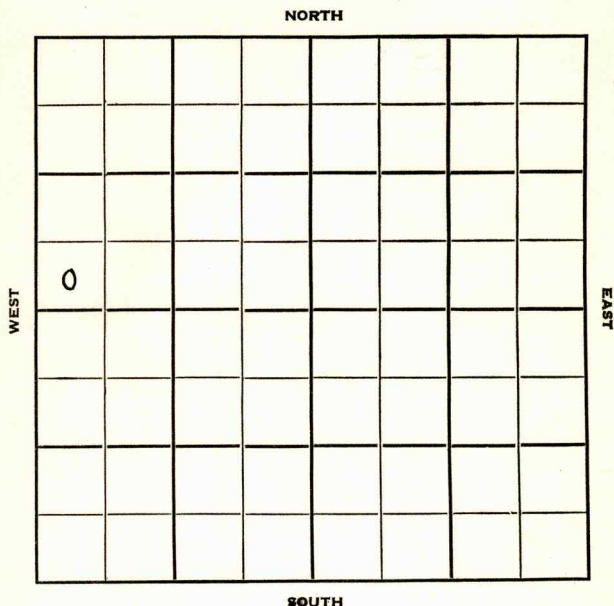

Greenwood **KANSAS**

Sec. 10 Twp. 22 R. 12E **V**

Well No. #2 Swanson "B" Farm

Glenwood Oil Company

Contractor

Ft. from N. Line

390'


Ft. from S. Line

Ft. from E. Line

330'

Ft. from W. Line

SW SW NW

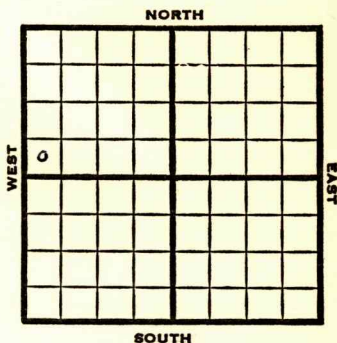

1951

Elev. -

REPORT

3/7

Location

5/16

Spud 3-11-51

Oil Well TD 1846

7" @ 84

Bart 1756 Sand 1816

TD 1846 4½" @ 1811

Comp. 7 bopd

COMPLETE

Sec. 10 (Blk. Twp.) 22 (Sur. Rge.) 12E Map No.

Operator Glenwood Oil

Well No. 2 Farm Swanson "B"

[illegible]

390 Ft. From S Line NW

330 Ft. From **W** Line Quarter

1st. Report MAR 7 1951

Completion

Remarks

Spudding Date _____

Drig. Data

Location

J. E. TYRA

Sec. 10 (Blk. Twp.) 22 (Sur. Rge.) 12E Map No.

Operator Glenwood Oil

Well No. 2 Farm Swanson "B"

Elev.	Location	SW	SW	NW
-------	----------	----	----	----

COMPLETE

390 Ft. From S Line NW

330 Ft. From W Line Quarter

1st. Report

Completion MAY 16 1951

Remarks

Spudding Date 3-11-51

Drlg. Data Oil well TD 1846

7" @ 84 Bart. 1756 Sand 1816

TD 1846 4 $\frac{1}{2}$ " @ 1811 Comp. 7 bopd

J. E. TYRA