

Map No. *Land* Sec. *10* Twp. *22* R. *13*
Well No. *1* *Hubbard* Farm
Callahan Etal Company

WEST

0

EAST

SOUTH

Drilling Remarks

Drilling Remarks

Cased _____ in. _____ ft.
 Sand _____
 Gas _____
 Oil _____
 Total Depth _____

1st 24 hrs. Nat. _____
1st 24 hrs. after shot _____
Gas _____ cu. ft.
Dry Hole _____
Abandoned _____

Greenwood

Map No. *Kansas* Sec. *10* Twp. *22* R *13*


Well No. *1* *Hubbard* Farm
Callahan et al Company

NORTH

WEST

EAST

SOUTH

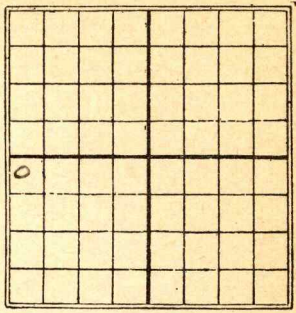

250 Ft. from N. Line

_____ Ft. from S. Line

_____ Ft. from E. Line

250 Ft. from W. Line

Date *1/26*

REPORT

<i>3/18</i>	<i>Location</i>
<i>3/25</i>	_____
<i>3/25</i>	_____
<i>4/1</i>	_____
<i>4/7</i>	_____
<i>4/14</i>	_____
<i>4/21</i>	_____
<i>4/30</i>	_____
<i>5/8</i>	<i>Same</i>
<i>5/12</i>	<i>Same</i>
<i>5/19</i>	_____
<i>6/2</i>	_____
<i>6/10</i>	_____
<i>6/18</i>	_____
<i>6/25</i>	_____
<i>6-30</i>	<i>Ry</i>
<i>7/8</i>	_____
<i>7/15</i>	_____
<i>7/22</i>	_____
<i>7/28</i>	<i>Dlg 410</i>
<i>8/4</i>	<i>" 450</i>
<i>8/11</i>	<i>" 850 10" 835</i>

8/18 - Dlg 1415'

8/25 - S.D. 1415'

8-31 sup sand 1490-1512 1/2 r.
that 100 qt, 800 oil w hbl.
30 gravity.

9/15 - 100/75 bbls.

32 grav., sand 1490-1512

Map No. _____ Sec. 10 Twp. 22 R. 13

Well No. 1 Hubbard
Callahan & Co Company

Contractor _____

COMPLETED

SECTION PLAT

6			

250 Ft. from N. Line

_____ Ft. from S. Line

_____ Ft. from E. Line

250 Ft. from W. Line

Location _____

Rig up _____

Drilling and Remarks:

100 75 Bl.
32 Br.

RECORD

Cased _____ in., _____ ft.

Sand 1490-1512

Gas _____

Oil _____

Total Depth 1512

PRODUCTION

1st 24 hrs. Nat. _____

1st 24 hrs. after shot. _____

Gas _____ Cu. Ft.

Dry Hole _____

Abandoned _____

Date

SEP 15 1926

CHAS. L. SHERWOOD

192

Scout

no map **KANSAS** *Steenwood*
 Map No. _____ Sec. *10* Twp. *22* R. *13*
 Well No. *1* *Hubbard* _____
O'Callahan & Son _____ Company

 Contractor

FIRST REPORTS

250 _____ Ft. from N. Line

_____ Ft. from S. Line

_____ Ft. from E. Line

250 _____ Ft. from W. Line

SECTION PLAT

0			

Location *✓* _____

Rig up _____

Drilling and Remarks:

RECORD

Cased _____ in., _____ ft.

Sand _____

Gas _____

Oil _____

Total Depth _____

PRODUCTION

1st 24 hrs. Nat. _____

1st 24 hrs. after shot _____

Gas _____ Cu. Ft.

Dry Hole _____

Abandoned _____

Date

MAR 18 1926

192

CHAS. L. SHERWOOD

Scout