

Greenwood

KANSAS ✓

FORM 51 25M 3-49 PETROL

10

22

13E

Section _____ Township _____ Range _____

Well No. #1 Elsbury

Company C. Johnson

Miscellaneous

NORTH

3

WEST

EAST

		o					

SOUTH

Sec. 10

Twp. 22

R. 13E

Well No. #1 Elsbury Farm

C. Johnson Company

Miscellaneous


940' Ft. from N. Line

Ft. from S. Line

730' Ft. from E. Line

Ft. from W. Line

SW NE NW

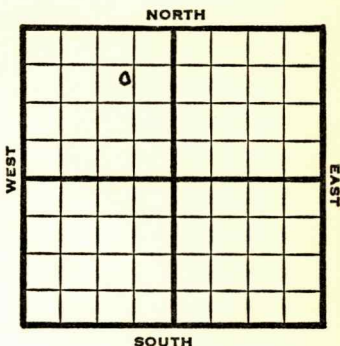

1949

REPORT

11/30

8" @ 170'

Squirrel 1495'

TD 1550'

D&A

TD 1550'

FIRST REPORT

ABANDONED

Map No. _____ Sec. 10 Twp. 22 R. 13E

Well No. 1 Elsbury

C. Johnson Company

Contractor

SW NE NW

FIRST REPORT
SECTION PLAT

940 Ft. from N. Line

_____ Ft. from S. Line

730 Ft. from E. Line

_____ Ft. from W. Line

ABANDONED			

Greenwood County

Location _____

Rig up _____

Drilling and Remarks:

8" @ 710

Squirrel 1495

TD 1550

D & A

RECORD

Cased _____ in., _____ ft.

Sand _____

Gas _____

Oil _____

Total Depth 1550

PRODUCTION

1st 24 hrs. Nat. _____

1st 24 hrs. after shot _____

Gas _____ Cu. Ft.

Dry Hole _____

Abandoned _____

Date

NOV 30 1949

19

S. J. LEWIS

Scout