


Section 10 Township 22 Range 11E

Well No. #1 Boone

Company P. L. Edwards

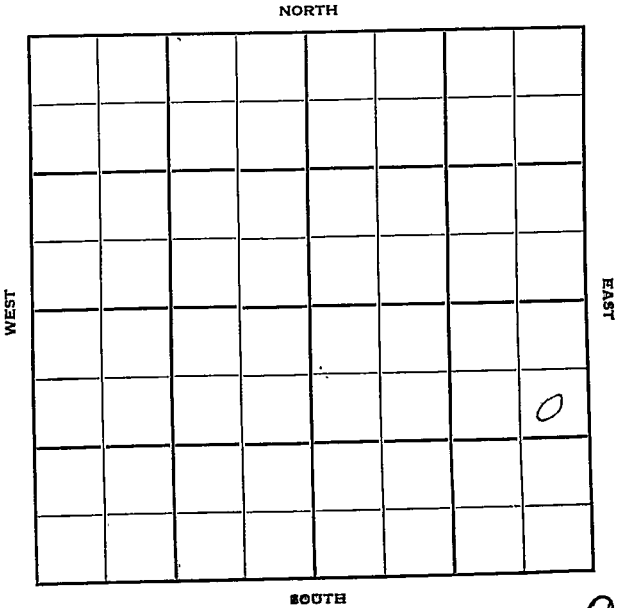

Sec. 10 Twp. 22 R. 11E

Well No. #1 Boone Farm

P. L. Edwards Company

Contractor


990' Ft. from N. Line

_____ Ft. from S. Line

50' Ft. from E. Line

_____ Ft. from W. Line

SE NE SE

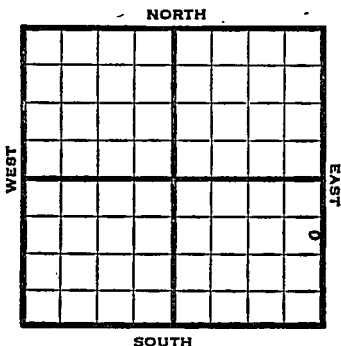

1951

Elev. - REPORT

10/24

RUR

12/5

Oil well TD 1809'
 Bart 1788' 5" @ 1789' TD 1809'
 40 qt/ 1788-1809'
 Comp. 10 BOPD

COMPLETED

