

10-22-11E



WELL LOG BUREAU—KANSAS GEOLOGICAL SOCIETY
508 East Murdock, Wichita, Kansas

Company- P.L. EDWARDS ET AL
Farm- Boone No. 1

SEC. 10 T. 22 R. 11E
SE NE SE

Total Depth. 1807'
Comm. 10-24-51 Comp. 10-27-51
Shot or Treated.
Contractor. Berentz Drlg. Co.
Issued. 4-30-55

County Greenwood
KANSAS

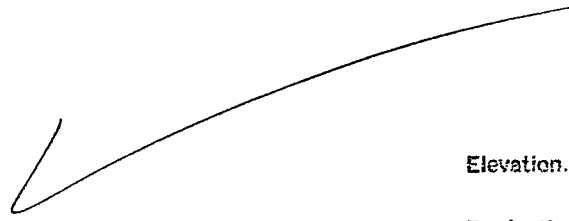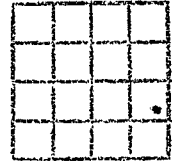

CASING:

5" 1789'

Elevation. _____

Production. 10 bbls.

Figures indicate Bottom of Formations

soil-shale	30
shale	60
shale-lime	495
lime w/shale stks	620
shale	735
sdv shale	865
lime	1010
shale-lime	1150
lime	1300
shale-lime	1395
shale	1410
lime	1420
shale	1430
lime	1450
shale-lime	1530
shale	1600
sand-wtr	1650
shale-lime	1699
Cattlemans ' sand	1710
shale-shells	1796
Bartlesville sand-	
show oil S.L. 1800'	1800
sand-took 7 1/2' core	1807
Total Depth	

Set 1795' casing & cemented.

Moved in cable tools & drilled 15'
new hole, which was black shale.