


Map No. _____ Sec. 10 Twp. 22 R. 11 ✓
 Well No. 1- Pees Farm _____
Henderson & Holdem Company

NORTH

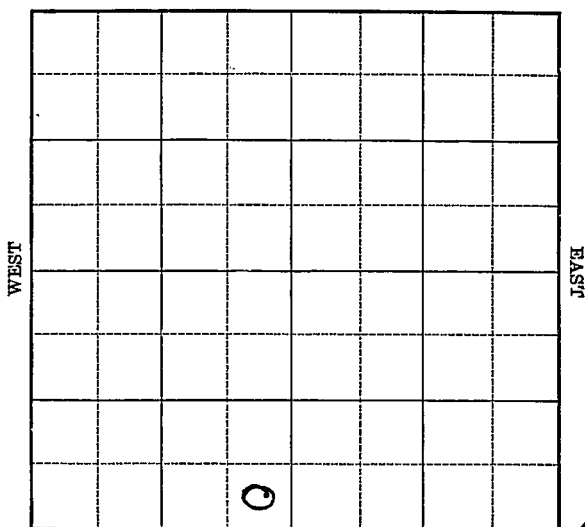

SOUTH

Location _____

Drilling Remarks _____

Rig Up _____

Drilling Remarks _____

RECORD

Cased _____ in. _____ ft.

Sand _____

Gas _____

Oil _____

Total Depth _____

PRODUCTION

1st 24 hrs. Nat. _____

1st 24 hrs. after shot _____

Gas _____ cu. ft.

Dry Hole _____

Abandoned _____

Map No. K Sec. 10 Twp. 22 R. 11Well No. 1 - Pees FarmHenderson-Halden Company

NORTH

_____ Ft. from N. Line

330 Ft. from S. Line330 Ft. from E. Line

_____ Ft. from W. Line

WEST

EAST

SOUTH

1927

Date

REPORT

Date	REPORT
7/13	R. O. G.
7/20	Rig
7/28	—
8/4	rig
8/10	—
8/18	rig
8/24	—
9/1	Drly 575
9/7	" 1500
9/14	Sdy shale 182.1-41
	D. & A. 1930'

Greenwood

21 KANSAS

Map No. _____ Sec 10 Twp. 22 R. 11Well No. 1 feesHenderson & Halden Company_____
Contractor

FIRST REPORTS

Ft. from N. Line330
Ft. from S. Line330
Ft. from E. Line_____
Ft. from W. Line

SECTION PLAT

Location _____

Rig up _____

Drilling and Remarks:

P.O.S.

RECORD

Cased _____ in., _____ ft.

Sand. _____

Gas _____

Oil _____

Total Depth _____

PRODUCTION

1st 24 hrs. Nat. _____

1st 24 hrs. after shot _____

Gas _____ Cu. Ft.

Dry Hole _____

Abandoned _____

Date

July 13 1927

CHAS. L. SHERWOOD

Scout

Map No. 21 KANSAS Sec. 10 Twp. 22 R. 11

Well No. 1 fees
Henderson & Holden Company

Contractor

COMPLETED

SECTION PLAT

	0		

_____ Ft. from N. Line

330 Ft. from S. Line

330 Ft. from E. Line

_____ Ft. from W. Line

ABANDONED

Location _____

Rig up _____

Drilling and Remarks:

Sdy shale 1821-41

RECORD

Cased _____ in., _____ ft.

Sand _____

Gas _____

Oil _____

Total Depth 1930

PRODUCTION

1st 24 hrs. Nat. _____

1st 24 hrs. after shot _____

Gas _____ Cu. Ft.

Dry Hole ☒

Abandoned ☒

Date

SEP 14 1927

CHAS. L. SHERWOOD

192

Scout